

TATE  
 D 2037  
 10-28-78

MISSISSIPPI  
 BOARD OF WATER COMMISSIONERS  
 416 North State Street  
 Jackson, Mississippi 39201

WATER WELL DRILLERS LOG

10-23-1978 Hick Well Co. Tate  
 date well completed firm name county well located


LANDOWNER: <u>Ocean Beach</u>	description of formations encountered	from	to
<u>Rt. 2</u>			
<u>Coldwater Ms.</u> (mailing address)	<u>Red Clay</u>	<u>0</u>	<u>20</u>
WELL LOCATION: sec. <u>32</u> T <u>4</u> N R <u>5</u> E	<u>Red Clay + sand</u>	<u>20</u>	<u>80</u>
— miles — of <u>Both</u> (distance) (direction) (nearest town)	<u>White Sand</u>	<u>80</u>	<u>140</u>
WELL PURPOSE: <u>Home</u> (home, irrigation, municipal, industrial)			
WELL COMPLETION DATA:			
(1) diameter (inches) <u>4</u>			
(2) total depth (feet) <u>140</u>			
(3) static water level (feet) <u>80</u> below top of ground.			
(4) casing <u>PVC</u> , <u>140</u> , (material) (depth)			
— If telescope see back. (size)			
(5) screen <u>7'</u> , <u>133</u> (length) (depth to top)			
<u>4"</u> , <u>gravel type</u> (size) (material)			
(6) pump <u>1/2</u> <u>10</u> (HP) (yield gpm)			
<u>220V</u> (type power)			
(7) electric log <u>No</u> (yes or no)			
(organization running log)			
(8) how well bottom plugged <u>Cap</u>			
DRILLERS REMARKS:			

RECEIVED

OCT 30 1978

If well telescopes please sketch and show depths.

GROUND LEVEL

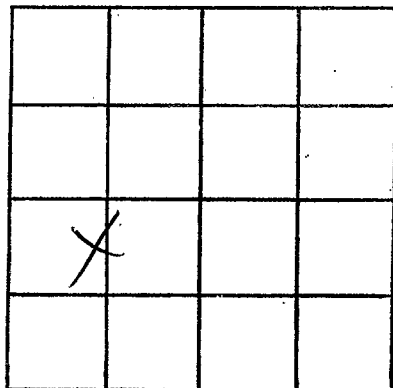

SECTION 32

Please indicate well location X.

ADDITIONAL INFORMATION

If more than one screen,  
show locations of each on sketch.