

TATE
D 2028
9-19-78

**MISSISSIPPI
BOARD OF WATER COMMISSIONERS**
416 North State Street
Jackson, Mississippi 39201
WATER WELL DRILLERS LOG

9-19 1978 Hicks well CO TATE
 date well completed firm name county well located

LANDOWNER: <u>George Rodgers</u>	description of formations encountered	from	to
<u>RT-2</u>			
<u>Cold water Miss</u> (mailing address)	<u>Red CLAY</u>	<u>0</u>	<u>40</u>
	<u>Red SAND & C</u>	<u>40</u>	<u>110</u>
	<u>W.S.</u>	<u>110</u>	<u>167</u>

WELL LOCATION:
 sec 19 T H N 5 E
2 miles First of Independence
 (distance) (direction) (nearest town)

WELL PURPOSE: Home
 (home, irrigation, municipal, industrial)

WELL COMPLETION DATA:

(1) diameter (inches) 4"

(2) total depth (feet) 167

(3) static water level (feet) 100 below top of ground.

(4) casing PVC, 167,
 (material) (depth)

_____ if telescope see back.
 (size)

(5) screen 7', 7'
 (length) (depth to top)

1/2", INSIDE ROCK
 (size) (material)

(6) pump 1/2 10
 (HP) (yield gpm)

220 FIRC
 (type power)

(7) electric log NO
 (yes or no)

_____ (organization running log)

(8) how well bottom plugged Cap


RECEIVED
 SEP 25 1978

DRILLERS REMARKS: _____

MISS. BD. OF WATER COMMISSIONERS

If well telescopes please sketch and show depths.

GROUND LEVEL

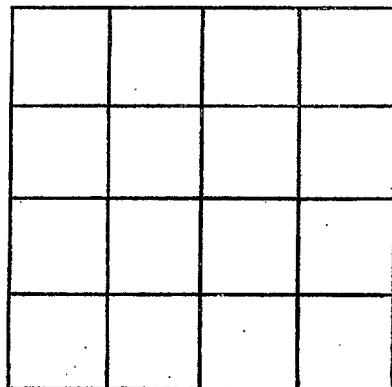

SECTION _____

Please indicate well location X.

ADDITIONAL INFORMATION

If more than one screen,
show locations of each on sketch.