

TATE  
 D 2007  
 11-14-78

MISSISSIPPI  
 BOARD OF WATER COMMISSIONERS  
 416 North State Street  
 Jackson, Mississippi 39201

WATER WELL DRILLERS LOG

11-14-78 date well completed  
 T.H. Hirschwell Co firm name  
 Tate county well located

LANDOWNER: Bobby W. Frank  
 Independence, Ms.  
 (mailing address)

description of formations encountered	from	to
Red Clay	0	10
Red Sand & Shale	10	65
White Sand	65	85
Shale & Sand	85	95
White Sand	95	102

WELL LOCATION:  
 sec. 12 T. 4 N. R. 6 E.  
 1/2 miles N of Wakefield  
 (distance) (direction) (nearest town)

WELL PURPOSE: Home  
 (home, irrigation, municipal, industrial)

WELL COMPLETION DATA:

(1) diameter (inches) 4

(2) total depth (feet) 102

(3) static water level (feet) 60 below above top of ground.

(4) casing PVC, 102 (material) (depth)

(size) if telescope see back.

(5) screen 7' 95 (length) (depth to top)

4" gravel type (size) (material)

(6) pump 1/2 10 (HP) (yield gpm)

220V (type power)

(7) electric log No (yes or no)

(organization running log)

(8) how well bottom plugged Cap

RESERVED


DEC 14 1978

DRILLERS REMARKS:

MISS. Bd. OF WATER COMMISSIONERS

If well telescopes please sketch and show depths.

GROUND LEVEL

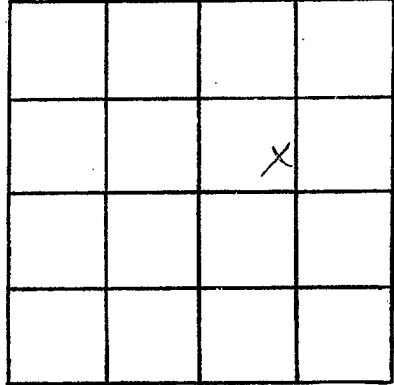

SECTION 12

Please indicate well location X.

ADDITIONAL INFORMATION

If more than one screen,  
show locations of each on sketch.