

TATE  
 D 2032  
 3-28-79  
 249  
 3-19

MISSISSIPPI  
 BOARD OF WATER COMMISSIONERS  
 416 North State Street  
 Jackson, Mississippi 39201

WATER WELL DRILLERS LOG

date well completed

firm name

county well located

1979 Rich Well Co. Tate

LANDOWNER:  
R. L. Patrick  
Rt. 2 Coldwater Miss  
 (mailing address)

| description of formations encountered | from      | to         |
|---------------------------------------|-----------|------------|
| <u>Red Sand</u>                       | <u>0</u>  | <u>10</u>  |
| <u>Sand + Gravel</u>                  | <u>10</u> | <u>90</u>  |
| <u>White Clay</u>                     | <u>90</u> | <u>95</u>  |
| <u>White Sand</u>                     | <u>95</u> | <u>145</u> |

WELL LOCATION:  
 sec. 32 T 4 N R. 5 E  
1/4 miles East of Bell  
 (distance) (direction) (nearest town)

WELL PURPOSE: Home  
 (home, irrigation, municipal, industrial)

WELL COMPLETION DATA:

(1) diameter (inches) 4 in

(2) total depth (feet) 145

(3) static water level (feet) 70 below above top of ground.

(4) casing 4 in 145  
 (material) (depth)

(size) if telescope see back.

(5) screen 7 ft 138  
 (length) (depth to top)

4 in Gravel  
 (size) (material)

(6) pump 1/2 10  
 (HP) (yield gpm)

220  
 (type power)

(7) electric log No  
 (yes or no)

(organization running log)

(8) how well bottom plugged Cap.

Miss. Board of Water Comm.


MAR 27 1979

RECEIVED

DRILLERS REMARKS:

If well telescopes please sketch and show depths.

GROUND LEVEL

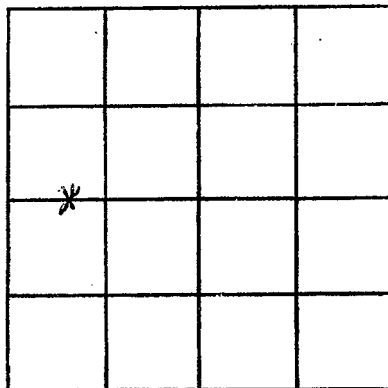

SECTION 32

Please indicate well location X.

ADDITIONAL INFORMATION

If more than one screen,  
show locations of each on sketch.