

TATE
 D 2033
 7-24-79

MISSISSIPPI
 BOARD OF WATER COMMISSIONERS
 416 North State Street
 Jackson, Mississippi 39201

WATER WELL DRILLERS LOG

7-24-79 19 date well completed
 Heiko Well Co. firm name
 Tate county well located

LANDOWNER:
 Bob Darnell
 Independence Miss
 (mailing address)

description of formations encountered	from	to
Red Clay	0	20
Red Sand	20	80
White sand	80	125

WELL LOCATION:
 sec. 30 T 4 N R 5 E
 2 1/2 miles N/E of Indep.
 (distance) (direction) (nearest town)

WELL PURPOSE: home
 (home, irrigation, municipal, industrial)

WELL COMPLETION DATA:

(1) diameter (inches) 7 25/32 in
 (2) total depth (feet) 125
 (3) static water level (feet) _____ below/above top of ground.
 (4) casing Plastic 125 (material) (depth)
 (size) If telescope see back.
 (5) screen 7 ft 11 ft (length) (depth to top)
 4 in. galvanized (size) (material)
 (6) pump 1/2 HP 10 (yield gpm)
 220 (type power)
 (7) electric log No (yes or no)
 (organization running log)
 (8) how well bottom plugged Cap

DRILLERS REMARKS:


Miss. Board of Water Comm.

AUG 7 1979

RECEIVED

If well telescopes please sketch and show depths.

GROUND LEVEL

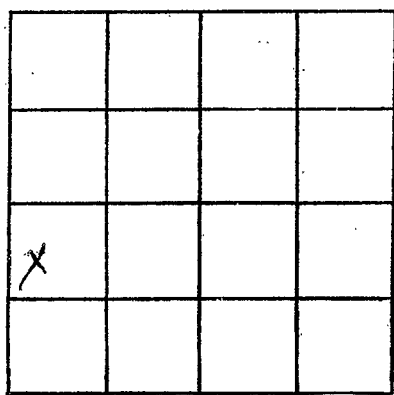

SECTION 30

Please indicate well location X.

ADDITIONAL INFORMATION

A series of horizontal lines for writing additional information.

If more than one screen, show locations of each on sketch.