

Tate
D2034
9-1-79

MISSISSIPPI
BOARD OF WATER COMMISSIONERS
416 North State Street
Jackson, Mississippi 39201

WATER WELL DRILLERS LOG

9-1-79 date well completed 29 Hecho Wells firm name Tate county well located

LANDOWNER:	description of formations encountered	from	to
Alvern Rodgers P.O. 4, Box 321, Coldwater (mailing address)	Red Clay	0	25
WELL LOCATION:	White Clay	25	60
sec. 9 T. 4 N. R. 5 E 4 1/2 miles N/E of Belt (distance) (direction) (nearest town)	White Sand	60	125
WELL PURPOSE: home (home, irrigation, municipal, industrial)			
WELL COMPLETION DATA:			
(1) diameter (inches) 4 in			
(2) total depth (feet) 125			
(3) static water level (feet) _____ below/above top of ground.			
(4) casing Plastic 125 (material) (depth)			
(size) If telescope see back.			
(5) screen 7 ft 118 (length) (depth to top)			
4 in Gravel (size) (material)			
(6) pump 1/2 10 (HP) (yield gpm)			
220 (type power)			
(7) electric log No (yes or no)			
(organization running log)			
(8) how well bottom plugged Cap			
DRILLERS REMARKS:			


Miss. Board of Water Comm.

SEP 11 1979

RECEIVED

If well telescopes please sketch and show depths.

GROUND LEVEL

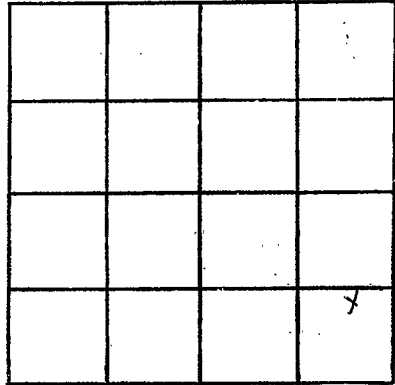

SECTION 9

Please indicate well location X.

ADDITIONAL INFORMATION

If more than one screen,
show locations of each on sketch.