

TATE
D
2036

**MISSISSIPPI
BOARD OF WATER COMMISSIONERS**
416 North State Street
Jackson, Mississippi 39201

WATER WELL DRILLERS LOG

date well completed 19 79 firm name Hecks Well Co. county well located Tate

LANDOWNER: Robert Elliott
Bett Community
(mailing address)

description of formations encountered	from	to
<u>Red Clay</u>	<u>0</u>	<u>30</u>
<u>Red sand</u>	<u>30</u>	<u>80</u>
<u>White sand</u>	<u>80</u>	<u>140</u>

WELL LOCATION:
sec. 28 T. 4 N. R. 5 E.
Bett Community
(distance) miles (direction) of (nearest town)

WELL PURPOSE: Home
(home, irrigation, municipal, industrial)

WELL COMPLETION DATA:

(1) diameter (inches) 4 in

(2) total depth (feet) 140

(3) static water level (feet) _____ below above top of ground.

(4) casing Plastic 140
(material) (depth)

(size) if telescope see back.

(5) screen 2 ft 130
(length) (depth to top)

4 in Gravel
(size) (material)

(6) pump 1/2 10
(HP) (yield gpm)

220
(type power)

(7) electric log No
(yes or no)

(organization running log)

(8) how well bottom plugged Cap

DRILLERS REMARKS:


Miss. Board of Water Comm.

AUG 1 1979

RECEIVED

If well telescopes please sketch and show depths.

GROUND LEVEL

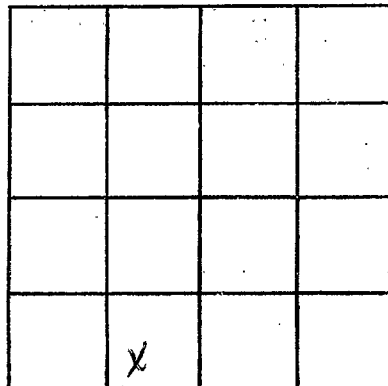

SECTION 28

Please indicate well location X.

ADDITIONAL INFORMATION

If more than one screen,
show locations of each on sketch.