

TATE  
D 2037  
6-13-79

MISSISSIPPI  
BOARD OF WATER COMMISSIONERS  
416 North State Street  
Jackson, Mississippi 39201

WATER WELL DRILLERS LOG

6-13 1979 Nichols Well Co. Tate  
date well completed firm name county well located

LANDOWNER:  
Farrow  
Rt. 2, Coldwater Miss  
(mailing address)


description of formations encountered	from	to
Red sand	0	20
Gravel	20	30
Red sand	30	125
White sand	125	155

WELL LOCATION:  
sec. 31 T 4 N R 5 E  
miles of Bell  
(distance) (direction) (nearest town)

WELL PURPOSE: home  
(home, irrigation, municipal, industrial)


WELL COMPLETION DATA:  
(1) diameter (inches) 4 in  
(2) total depth (feet) 155  
(3) static water level (feet) \_\_\_\_\_ below top of ground.  
(4) casing Plastic 155 (material) (depth)  
(5) screen 7 1/2' 148 (length) (depth to top)  
4 in Gravel (size) (material)  
(6) pump 1/2 70 (HP) (yield gpm)  
220 (type power)  
(7) electric log No (yes or no)  
(organization running log)  
(8) how well bottom plugged Cap

DRILLERS REMARKS:

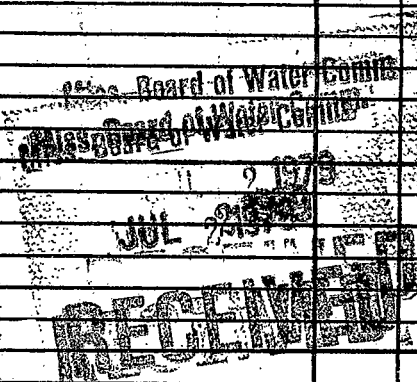

If well telescopes please sketch and show depths.

GROUND LEVEL

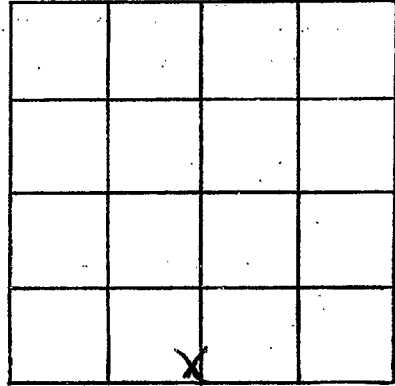

SECTION 31

Please indicate well location X.

ADDITIONAL INFORMATION

If more than one screen, show locations of each on sketch.