

Tate
D
2038
11-7-79

MISSISSIPPI
 BOARD OF WATER COMMISSIONERS
 416 North State Street
 Jackson, Mississippi 39201

WATER WELL DRILLERS LOG

11-7 19 79 ~~11-7-79~~ Nicks Wells Tate
 date well completed firm name county well located

LANDOWNER:
A. Y. Mayo
P.O. 4, Coldwater
 (mailing address)

description of formations encountered	from	to
<u>Clay</u>	<u>0</u>	<u>30</u>
<u>red sand</u>	<u>30</u>	<u>90</u>
<u>white sand</u>	<u>90</u>	<u>140</u>

WELL LOCATION:
 sec. 20 T. 4 N R. 5 E
2 miles N of Belt
 (distance) (direction) (nearest town)

WELL PURPOSE: home
 (home, irrigation, municipal, industrial)

WELL COMPLETION DATA:
 (1) diameter (inches) 4 in
 (2) total depth (feet) 140
 (3) static water level (feet) _____ below above top of ground.
 (4) casing Plastic 140
 (material) (depth)
 (size) if telescope see back.
 (5) screen 7 ft 133
 (length) (depth to top)
1/2 in Gravel
 (size) (material)
 (6) pump 1/2 10
 (HP) (yield gpm)
220
 (type power)
 (7) electric log No
 (yes or no)
 (organization running log)

(8) how well bottom plugged Cap
 DRILLERS REMARKS:


DEPT. OF NATURAL RESOURCES
 BUREAU OF LAND & WATER RESOURCES

NOV 13 1979

RECEIVED

If well telescopes please sketch and show depths.

GROUND LEVEL

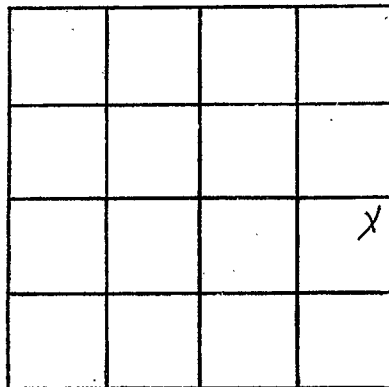

SECTION 20

Please indicate well location X.

ADDITIONAL INFORMATION

If more than one screen,
show locations of each on sketch.