

Tate
D
205
11-7-79

MISSISSIPPI
BOARD OF WATER COMMISSIONERS
416 North State Street
Jackson, Mississippi 39201

WATER WELL DRILLERS LOG

11-7-79 date well completed 1979 Necker Well Co. firm name Tate county well located

LANDOWNER:
Ozell Mayo
Rt. 4, Coldwater
(mailing address)

description of formations encountered	from	to
Clay	0	30
red sand	30	90
white sand	90	155

WELL LOCATION:
sec. 20 T 4 N R 5 E
2 miles (distance) of (direction) of (nearest town)

WELL PURPOSE: home
(home, irrigation, municipal, industrial)

- WELL COMPLETION DATA:
- (1) diameter (inches) 4 in
 - (2) total depth (feet) 153
 - (3) static water level (feet) _____ below above top of ground.
 - (4) casing Plastic 155 (material) (depth)
 - (size) if telescope see back.
 - (5) screen 7 ft 148 (length) (depth to top)
4 in Gravel (size) (material)
 - (6) pump 1/2 10 (HP) (yield gpm)
220 (type power)
 - (7) electric log No (yes or no)


(organization running log)
(8) how well bottom plugged Cap

DRILLERS REMARKS:

DEPT. OF NATURAL RESOURCES
BUREAU OF LAND & WATER RESOURCES
NOV 18
RECEI

If well telescopes please sketch and show depths.

GROUND LEVEL

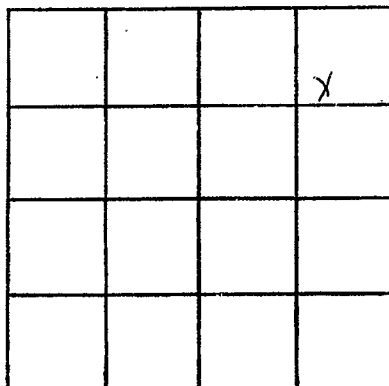

SECTION _____

Please indicate well location X.

ADDITIONAL INFORMATION

If more than one screen, show locations of each on sketch.