

TATE
D 2040
1-15-80

MISSISSIPPI
BOARD OF WATER COMMISSIONERS
416 North State Street
Jackson, Mississippi 39201

CODED

WATER WELL DRILLERS LOG

1-15-80 date well completed 1980 Wells W. Co. firm name Tate county well located

LANDOWNER:
James Caplan
P.O. 2. Coldwater
(mailing address)

description of formations encountered	from	to
Red Clay	0	20
White Clay & Sand	20	60
White Sand	60	108

WELL LOCATION:
sec. 30 T. 4 N R. 5 E
3/4 miles of Bet
(distance) (direction) (nearest town)

WELL PURPOSE: home
(home, irrigation, municipal, industrial)

WELL COMPLETION DATA:

(1) diameter (inches) 4 in

(2) total depth (feet) 108

(3) static water level (feet) 60 below above top of ground.

(4) casing Plaster 108 (material) (depth)

(size) if telescope see back.

(5) screen 7 ft 101 (length) (depth to top)
4 in Gravel (size) (material)

(6) pump 1/2 10 (HP) (yield gpm)
220 (type power)

(7) electric log No (yes or no)

(organization running log)

(8) how well bottom plugged cap


DRILLERS REMARKS:

DEPT. OF NATURAL RESOURCES
BUREAU OF LAND & WATER RESOURCES

FEB 15 1980
RECEIVED

If well telescopes please sketch and show depths.

GROUND LEVEL

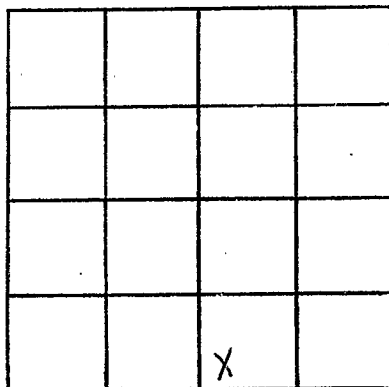

SECTION _____

Please indicate well location X.

ADDITIONAL INFORMATION

If more than one screen, show locations of each on sketch.