

Tate  
D 2041  
4-1-80  
4-1-80

MISSISSIPPI  
BOARD OF WATER COMMISSIONERS  
416 North State Street  
Jackson, Mississippi 39201

WATER WELL DRILLERS LOG

Richs Well Co.

Tate  
Marshall  
county well located

date well completed

firm name

county well located

LANDOWNER:

Donald Allen  
Rt. 2, Waterford Miss  
(mailing address)

description of formations encountered

from

to

clay	0	20
red sand	20	80
white sand	80	170

WELL LOCATION:

sec. 33 T 4 N R 6 E  
E of Brackch.  
(distance) (direction) (nearest town)

WELL PURPOSE:

(home, irrigation, municipal, industrial)

WELL COMPLETION DATA:

- (1) diameter (inches) 4 in
- (2) total depth (feet) 170
- (3) static water level (feet) 140 below top of ground.
- (4) casing Plastic 140  
(material) (depth)
- (size) if telescope see back.
- (5) screen 7ft 133  
(length) (depth to top)  
4in gravel  
(size) (material)
- (6) pump 1/2 10  
(HP) (yield gpm)  
220  
(type power)
- (7) electric log No  
(yes or no)

(organization running log)

(8) how well bottom plugged Cap


DRILLERS REMARKS:

DEPT. OF NATURAL RESOURCES  
BUREAU OF LAND & WATER RESOURCES

APR 29 1980  
RECEIVED

If well telescopes please sketch and show depths.

GROUND LEVEL

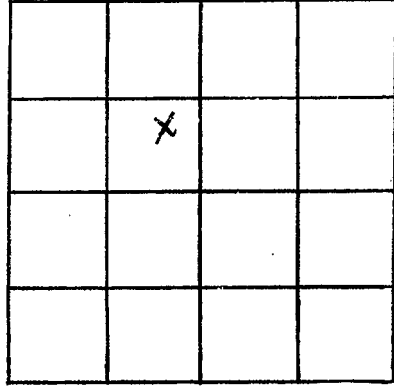

SECTION 33

Please indicate well location X.

ADDITIONAL INFORMATION

If more than one screen,  
show locations of each on sketch.