

Tate
 D 2042
 8-20-80

MISSISSIPPI
 BOARD OF WATER COMMISSIONERS
 416 North State Street
 Jackson, Mississippi 39201

WATER WELL DRILLERS LOG

8-20-80 date well completed Hick Well Co. firm name Tate county well located

LANDOWNER: <u>Willie Batt</u> <u>Rt. 4 Box 287</u> <u>Coldwater, Ms.</u> (mailing address)	description of formations encountered <u>clay</u> <u>white sand</u>	from	to
		<u>0</u>	<u>30</u>
WELL LOCATION: sec <u>20</u> T <u>4</u> N R <u>5</u> E <u>2</u> miles <u>W</u> of <u>Walden</u> (distance) (direction) (nearest town)			
WELL PURPOSE: <u>Home</u> (home, irrigation, municipal, industrial)			
WELL COMPLETION DATA:			
(1) diameter (inches)	<u>4</u>		
(2) total depth (feet)	<u>125</u>		
(3) static water level (feet)	<u>20</u>	below	above
		top of ground.	
(4) casing	<u>PVC</u>	<u>125</u>	
	(material)	(depth)	
	if telescope see back.		
	(size)		
(5) screen	<u>7'</u>	<u>118</u>	
	(length)	(depth to top)	
	<u>4"</u>	<u>gravel type</u>	
	(size)	(material)	
(6) pump	<u>1/2</u>	<u>10</u>	
	(HP)	(yield gpm)	
	<u>220v</u>		
	(type power)		
(7) electric log	<u>No</u>		
	(yes or no)		
	(organization running log)		
(8) how well bottom plugged	<u>Cap</u>		

DRILLERS REMARKS:


DEPT. OF NATURAL RESOURCES
 BUREAU OF LAND & WATER RESOURCES

SEP 29 1980

RECEIVED

If well telescopes please sketch and show depths.

GROUND LEVEL

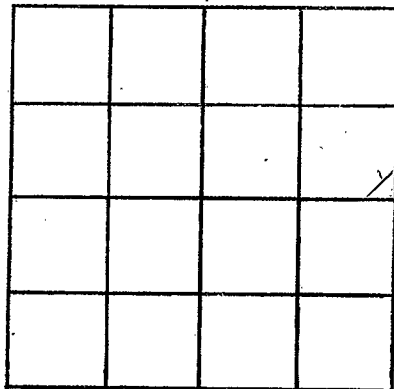

SECTION 20

Please indicate well location X.

ADDITIONAL INFORMATION

If more than one screen, show locations of each on sketch.