

TATE
 D 2043
 9-23-80

MISSISSIPPI
 BOARD OF WATER COMMISSIONERS
 416 North State Street
 Jackson, Mississippi 39201

WATER WELL DRILLERS LOG

9-23 1980 Hicks Well Co. Tata
 date well completed firm name county well located

LANDOWNER: Mitchell Penn
P.O. Box 5
Independence, Mo.
 (mailing address)

description of formations encountered	from	to
<u>Red Clay</u>	<u>0</u>	<u>10</u>
<u>white sand</u>	<u>10</u>	<u>110</u>

WELL LOCATION:
 sec. 6 T. 4 N. R. 5 E
3 miles NW of Watafield
 (distance) (direction) (nearest town)

WELL PURPOSE: home
 (home, irrigation, municipal, industrial)


- WELL COMPLETION DATA:
- (1) diameter (inches) 4
 - (2) total depth (feet) 110
 - (3) static water level (feet) 60 ~~below~~ ^{above} top of ground.
 - (4) casing PVC, 110,
 (material) (depth)
 (size) If telescope see back.
 - (5) screen 7, 103
 (length) (depth to top)
4", gravel type
 (size) (material)
 - (6) pump 1/2, 10
 (HP) (yield gpm)
220v
 (type power)
 - (7) electric log No
 (yes or no)
 (organization running log)
 - (8) how well bottom plugged Cap

DRILLERS REMARKS:

DEPT. OF NATURAL RESOURCES
 BUREAU OF LAND & WATER RESOURCES
 OCT 29 1980
 RECEIVED

If well telescopes please sketch and show depths.

GROUND LEVEL

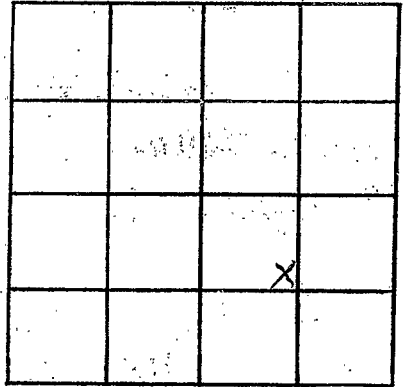

SECTION 6

Please indicate well location X.

ADDITIONAL INFORMATION

If more than one screen,
show locations of each on sketch.