

TATE
D 2044
9-23-80

MISSISSIPPI
BOARD OF WATER COMMISSIONERS
416 North State Street
Jackson, Mississippi 39201

WATER WELL DRILLERS LOG

9-23 1980 Hicks Well Co. Tate
date well completed firm name county well located

LANDOWNER: Ralph Jackson
3215 Helen St
Phosphor, La.
(mailing address)

description of formations encountered	from	to
Red sand	0	15
white sand	15	125

WELL LOCATION:
sec 6 T 4 N R 5 E
3 miles NW of Wikefield
(distance) (direction) (nearest town)

WELL PURPOSE: Home
(home, irrigation, municipal, industrial)


- WELL COMPLETION DATA:
- (1) diameter (inches) 4
 - (2) total depth (feet) 125
 - (3) static water level (feet) 60 below top of ground.
 - (4) casing PVC, 125,
(material) (depth)
(size) if telescope see back.
 - (5) screen 7, 118
(length) (depth to top)
4", gravel type
(size) (material)
 - (6) pump 1/2, 10
(HP) (yield gpm)
220V
(type power)
 - (7) electric log No.
(yes or no)
(organization running log)
 - (8) how well bottom plugged Cap

DEPT. OF NATURAL RESOURCES
BUREAU OF LAND & WATER RESOURCES
OCT 29 1980
RECEIVED

DRILLERS REMARKS:

If well telescopes please sketch and show depths.

GROUND LEVEL

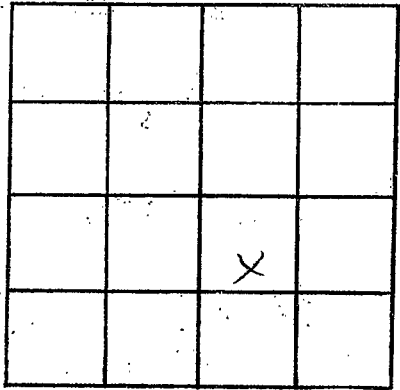

SECTION 6

Please indicate well location X.

ADDITIONAL INFORMATION

If more than one screen, show locations of each on sketch.