

TATE
D 2045
9-3-80

MISSISSIPPI
BOARD OF WATER COMMISSIONERS
416 North State Street
Jackson, Mississippi 39201

WATER WELL DRILLERS LOG

9/3/80 date well completed
G. Smith Well Dr. Tate firm name
county well located

LANDOWNER:
Harold Jackson
Independence, Mo
(mailing address)

description of formations encountered	from	to
top soil	0	5
red clay	5	60
red sand	60	135

WELL LOCATION:
sec 30 T 4 N R 5 E
2 1/2 miles SE of Independence
(distance) (direction) (nearest town)

WELL PURPOSE:
(home, irrigation, municipal, industrial)

- WELL COMPLETION DATA:
- (1) diameter (inches) 4"
 - (2) total depth (feet) 135'
 - (3) static water level (feet) 98' below top of ground
 - (4) casing Plastic 135' (material) (depth)
 - (size) If telescope see back.
 - (5) screen 10' length, 135' depth to top
4" plastic (size) (material)
 - (6) pump 1/2 HP, 10 (yield gpm)
elec (type power)
 - (7) electric log (yes or no)
 - (organization running log)
 - (8) how well bottom plugged Cap

DEPT. OF NATURAL RESOURCES
BUREAU OF LAND & WATER RESOURCES


OCT 15 1980

RECEIVED

DRILLERS REMARKS:

If well telescopes please sketch and show depths.

GROUND LEVEL

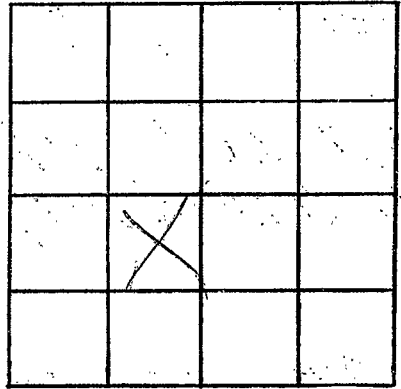

SECTION _____

Please indicate well location X.

ADDITIONAL INFORMATION

If more than one screen,
show locations of each on sketch.