

MISSISSIPPI DEPARTMENT OF NATURAL RESOURCES

Bureau of Land and Water Resources

Southport Mall

P.O. Box 10631

Jackson, Mississippi 39209

WATER WELL DRILLERS LOG

Date
Done

9-3-1982 Bob Smith Tate  
 date well completed firm name county well located

LANDOWNER: Harold Jackson  
Independence, Mo.  
 (mailing address)

description of formations encountered	from	to
top soil	0	5
<del>red clay</del> clay	5	75
white sand	75	135

WELL LOCATION:  
 sec 29 T 4 N R 5 E  
6 miles E. of Chd.  
 (distance) (direction) (nearest town)

WELL PURPOSE:  
 (home) irrigation, municipal, industrial

WELL COMPLETION DATA:

(1) diameter (inches) 4"

(2) total depth (feet) 135'

(3) static water level (feet) 80  below above top of ground.

(4) casing plastic, 135'  
 (material) (depth)

\_\_\_\_\_ if telescope see back.  
 (size)

(5) screen 10', 125'  
 (length) (depth to top)

4", plastic  
 (size) (material)

(6) pump 1/2, 10  
 (HP) (yield gpm)

elec  
 (type power)

(7) electric log  (yes or no)

\_\_\_\_\_ (organization running log)

(8) how well bottom plugged cap

DRILLERS REMARKS: \_\_\_\_\_


DEPT. OF NATURAL RESOURCES  
 BUREAU OF LAND & WATER RESOURCES

OCT 12 1982

RECEIVED

If well telescopes please sketch and show depths.

GROUND LEVEL

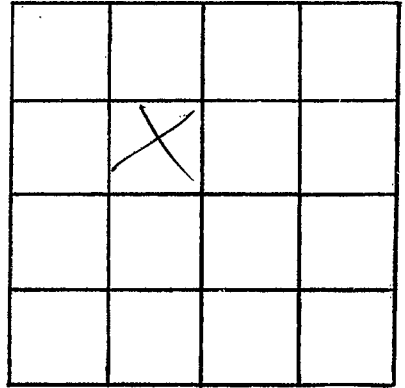

SECTION \_\_\_\_\_

Please indicate well location X.

ADDITIONAL INFORMATION

If more than one screen,  
show locations of each on sketch.