

# MISSISSIPPI DEPARTMENT OF NATURAL RESOURCES

Bureau of Land and Water Resources

Southport Mall

P.O. Box 10631

Jackson, Mississippi 39209

## WATER WELL DRILLERS LOG

Date D 2007

8-16 date well completed Bo/ Bob Smith firm name Tate county well located

LANDOWNER: Charles Drough description of formations encountered top soil from 0' to 5'  
Wall Hill, MS red clay 5' 90'  
 (mailing address) white sand 90' 135'

WELL LOCATION:  
 sec 28 T 4 N S R 5 E W  
8 miles E. of Chd.  
 (distance) (direction) (nearest town)

WELL PURPOSE:  
 (home, irrigation, municipal, industrial)

WELL COMPLETION DATA:  
 (1) diameter (inches) 4 1/2"  
 (2) total depth (feet) 135'  
 (3) static water level (feet) 80' below above top of ground.  
 (4) casing plastic 135'  
 (material) (depth)  
 (size) If telescope see back.  
 (5) screen 10 125'  
 (length) (depth to top)  
4" plastic  
 (size) (material)  
 (6) pump 1/2 10  
 (HP) (yield gpm)  
elec.  
 (type power)  
 (7) electric log (yes or no)

(organization running log)

(8) how well bottom plugged Cap

DRILLERS REMARKS:


DEPT. OF NATURAL RESOURCES  
 BUREAU OF LAND & WATER RESOURCES

OCT 12 1982

RECEIVED

If well telescopes please  
sketch and show depths.

GROUND LEVEL

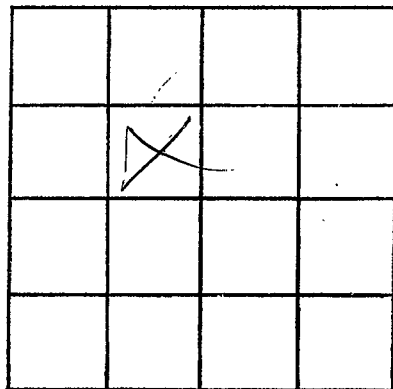

SECTION \_\_\_\_\_

Please indicate well location X.

ADDITIONAL INFORMATION

If more than one screen,  
show locations of each on sketch.