

MISSISSIPPI DEPARTMENT OF NATURAL RESOURCES

Bureau of Land and Water Resources

Southport Mall

P.O. Box 10631

Jackson, Mississippi 39209

WATER WELL DRILLERS LOG

TAKE  
D 2007  
5/13/81

5-13 1981 Hickel Well Co date well completed  
firm name  
Tate county well located

LANDOWNER: Sarah Carathan  
Pt. 4  
Caldwell, Mrs.  
(mailing address)

description of formations encountered	from	to
Red Sand	0	50
Gravel + sand	50	80
white sand	80	140

WELL LOCATION:  
sec. 20 T 4 N R 5 E  
2 miles NW of Wall Hill  
(distance) (direction) (nearest town)

WELL PURPOSE: Home  
(home, irrigation, municipal, industrial)


- WELL COMPLETION DATA:
- (1) diameter (inches) 4
  - (2) total depth (feet) 140
  - (3) static water level (feet) 25 below above top of ground.
  - (4) casing PVC 140 (material) (depth)  
if telescope see back.
  - (5) screen 12 128 (length) (depth to top)  
4 (size) gravel + PVC (material)
  - (6) pump 1/2 10 (HP) (yield gpm)  
2200 (type power)
  - (7) electric log No (yes or no)  
(organization running log)
  - (8) how well bottom plugged Cup



DRILLERS REMARKS:

If well telescopes please sketch and show depths.

GROUND LEVEL

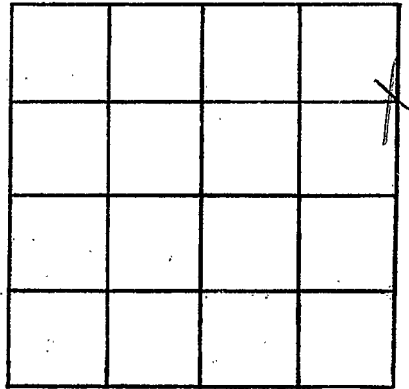

SECTION 20

Please indicate well location X.

ADDITIONAL INFORMATION

If more than one screen, show locations of each on sketch.