

MISSISSIPPI DEPARTMENT OF NATURAL RESOURCES

Bureau of Land and Water Resources

Southport Mall

P.O. Box 10631

Jackson, Mississippi 39209

WATER WELL DRILLERS LOG

TATE
D 2050
6-4-81

6-4 19 81 date well completed High Well Co firm name Tate county well located

LANDOWNER: Jois May
Rt 4
Caldwater Mo.
 (mailing address)

description of formations encountered	from	to
Red Clay	0	20
Gravel, Clay, Sand	20	50
White Sand	50	132

WELL LOCATION:
 sec. 20 T 4 N R 5 E
2 miles W of Wall Hill
 (distance) (direction) (nearest town)

WELL PURPOSE: Home
 (home, irrigation, municipal, industrial)


WELL COMPLETION DATA:

- (1) diameter (inches) 4
- (2) total depth (feet) 132
- (3) static water level (feet) 20 below above top of ground.
- (4) casing PVC, 132,
 (material) (depth)
- if telescope see back.
 (size)
- (5) screen 10, 122
 (length) (depth to top)
4", PVC
 (size) (material)
- (6) pump 1/2, 10
 (HP) (yield gpm)
72.0V
 (type power)
- (7) electric log No
 (yes or no)

(organization running log)


(8) how well bottom plugged Cap

DRILLERS REMARKS:

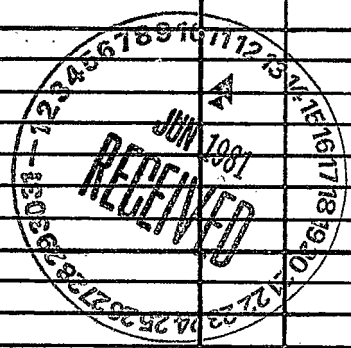

If well telescopes please sketch and show depths.

GROUND LEVEL

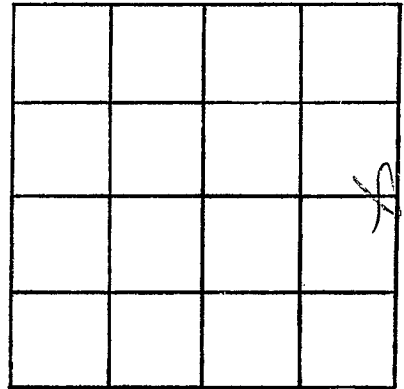

SECTION 20

Please indicate well location X.

ADDITIONAL INFORMATION

A series of horizontal lines providing space for additional information.

If more than one screen,
show locations of each on sketch.