

MISSISSIPPI DEPARTMENT OF NATURAL RESOURCES

Bureau of Land and Water Resources

Southport Mall

P.O. Box 10631

Jackson, Mississippi 39209

WATER WELL DRILLERS LOG

Date D  
2051

2-29-81 19 Bob Smith Itte  
 date well completed firm name county well located

LANDOWNER:  
Ralph Farrow  
Independence, Mo  
 (mailing address)

description of formations encountered	from	to
<u>top soil</u>	<u>0</u>	<u>5</u>
<u>red clay</u>	<u>5</u>	<u>38</u>
<u>gravel</u>	<u>28</u>	<u>78</u>
<u>white clay</u>	<u>98</u>	<u>174</u>
<u>sand</u>	<u>174</u>	<u>200</u>

WELL LOCATION:  
 sec 30 T 4 N R 5 E  
3 miles E of Ida  
 (distance) (direction) (nearest town)

WELL PURPOSE:  
 (home, irrigation, municipal, industrial)

WELL COMPLETION DATA:

(1) diameter (inches) 4"

(2) total depth (feet) 200'

(3) static water level (feet) 80' below above top of ground.

(4) casing plastic, 200'  
 (material) (depth)

\_\_\_\_\_ if telescope see back.  
 (size)

(5) screen 20', 180'  
 (length) (depth to top)

4", plastic  
 (size) (material)

(6) pump 3/4, 10  
 (HP) (yield gpm)

elec  
 (type power)

(7) electric log \_\_\_\_\_  
 (yes or no)

\_\_\_\_\_ (organization running log)

(8) how well bottom plugged cap

DRILLERS REMARKS:


DEPT. OF NATURAL RESOURCES  
 BUREAU OF LAND & WATER RESOURCES

OCT 12 1982

RECEIVED

If well telescopes please sketch and show depths.

GROUND LEVEL

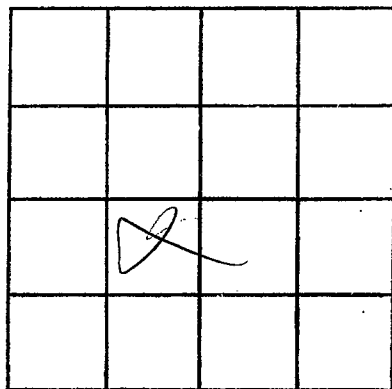

SECTION \_\_\_\_\_

Please indicate well location X.

ADDITIONAL INFORMATION

If more than one screen,  
show locations of each on sketch.