

MISSISSIPPI DEPARTMENT OF NATURAL RESOURCES

Bureau of Land and Water Resources

Southport Mall

P.O. Box 10631

Jackson, Mississippi 39209

WATER WELL DRILLERS LOG

TATE
 D 2052
 6-5-81

6-5 1981 date well completed Hicho Well Co. firm name Tate county well located

LANDOWNER: Joe Willie Sharp	description of formations encountered	from	to
PTA 4			
Caldwater, Mo. (mailing address)	Red Clay	0	20
	Red Sand & Gravel	20	50

WELL LOCATION:
 sec 20 T 4 N R 5 E
 3 miles W of White Hill
 (distance) (direction) (nearest town)


WELL PURPOSE: Home
 (home, irrigation, municipal, industrial)

- WELL COMPLETION DATA:
- (1) diameter (inches) 4
 - (2) total depth (feet) 140
 - (3) static water level (feet) 80 below above top of ground.
 - (4) casing PVC 140 (material) (depth)
 - (size) if telescope see back.
 - (5) screen 10' 130 (length) (depth to top)
 - (size) 4 (material) PVC
 - (6) pump 1/2 10 (HP) (yield gpm)
 - (type power) 220V
 - (7) electric log (yes or no)

(organization running log)


(8) how well bottom plugged Cap

DRILLERS REMARKS:

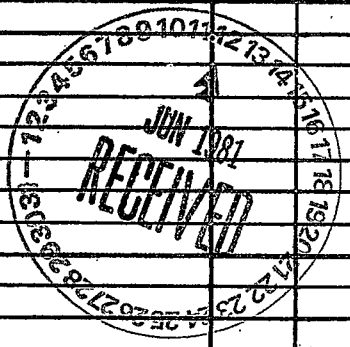

If well telescopes please sketch and show depths.

GROUND LEVEL

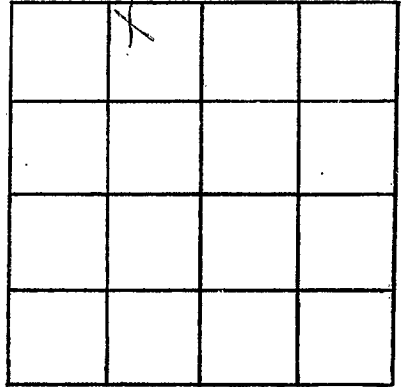

SECTION 20

Please indicate well location X.

ADDITIONAL INFORMATION

If more than one screen,
show locations of each on sketch.