

MISSISSIPPI DEPARTMENT OF NATURAL RESOURCES

Bureau of Land and Water Resources

Southport Mall

P.O. Box 10631

Jackson, Mississippi 39209

WATER WELL DRILLERS LOG

TATE
D2553
6-9-81

6-9 1981 date well completed      Hicks Well Co. firm name      Tate county well located

LANDOWNER: Tommy Boyd  
43 Hwy #305  
Olive Branch, Mo.  
(mailing address)

description of formations encountered	from	to
Red Clay	0	20
Gravel + Red Sand	20	70

WELL LOCATION:  
sec. 17 T 4 N R 5 E  
1 miles E of Wakefield  
(distance) (direction) (nearest town)

White Clay + Sand	70	125
White Sand	125	167

WELL PURPOSE: Home  
(home, irrigation, municipal, industrial)

WELL COMPLETION DATA:

(1) diameter (inches) 4

(2) total depth (feet) 167

(3) static water level (feet) 150 below top of ground.

(4) casing PVC, 167, (material) (depth)

(size) If telescope see back.

(5) screen 12, 155 (length) (depth to top)

4" PVC (size) (material)


(6) pump 1/2, 10 (HP) (yield gpm)

220v (type power)

(7) electric log No (yes or no)

(organization running log)


(8) how well bottom plugged Cap

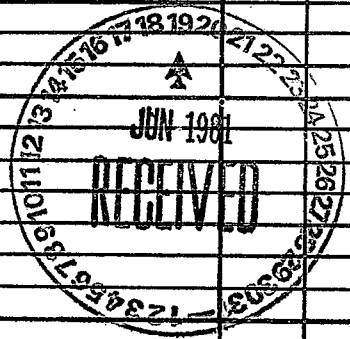

DRILLERS REMARKS:

If well telescopes please sketch and show depths.

GROUND LEVEL

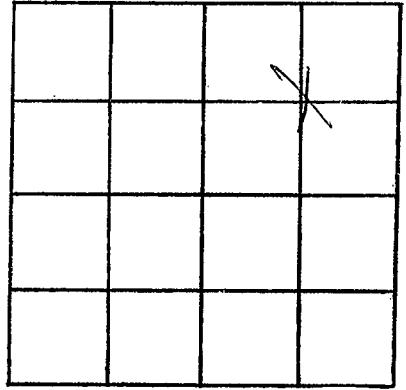

SECTION 17

Please indicate well location X.

ADDITIONAL INFORMATION

If more than one screen,  
show locations of each on sketch.