

MISSISSIPPI DEPARTMENT OF NATURAL RESOURCES

Bureau of Land and Water Resources

Southport Mall

P.O. Box 10631

Jackson, Mississippi 39209

WATER WELL DRILLERS LOG


Late  
D2054  
7-15-81

7-15 1981  
date well completed

Hicks Well Co  
firm name


Tate  
county well located

LANDOWNER:	description of formations encountered	from	to
<u>Daniel Bradshaw</u> <u>Rt. 3</u> <u>Colquhoun, Ms.</u> (mailing address)			
<b>WELL LOCATION:</b> sec. <u>6</u> T. <u>4</u> N. R. <u>5</u> E <u>1</u> miles <u>NE</u> of <u>Wakefield</u> (distance) (direction) (nearest town)	<u>Red sand + pea gravel</u>	<u>10</u>	<u>35</u>
<b>WELL PURPOSE:</b> (home, irrigation, municipal, industrial)	<u>White sand + pea gravel</u>	<u>35</u>	<u>65</u>
<b>WELL COMPLETION DATA:</b>	<u>White sand</u>	<u>65</u>	<u>132</u>
(1) diameter (inches) <u>4</u>			
(2) total depth (feet) <u>132</u>			
(3) static water level (feet) <u>80</u> below above top of ground.			
(4) casing <u>PVC</u> , <u>132</u> , (material) (depth)			
<u>—</u> If telescope see back. (size)			
(5) screen <u>12</u> , <u>120</u> (length) (depth to top)			
<u>4</u> W, <u>gravel + PVC</u> (size) (material)			
(6) pump <u>1/2</u> , <u>10</u> (HP) (yield gpm)			
<u>220V</u> (type power)			
(7) electric log <u>no</u> (yes or no)			
(organization running log)			
(8) how well bottom plugged <u>cap</u>			
<b>DRILLERS REMARKS:</b>			

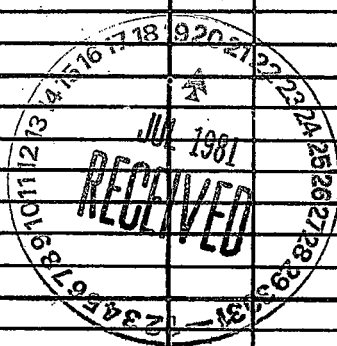

If well telescopes please sketch and show depths.

GROUND LEVEL

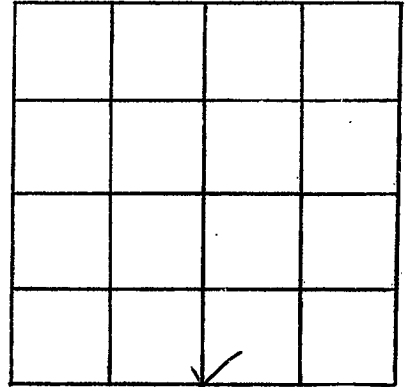

SECTION 6

Please indicate well location X.

ADDITIONAL INFORMATION

If more than one screen,  
show locations of each on sketch.