

MISSISSIPPI DEPARTMENT OF NATURAL RESOURCES

Bureau of Land and Water Resources

Southport Mall

P.O. Box 10631

Jackson, Mississippi 39209

WATER WELL DRILLERS LOG

HICKS WELL CO.

Rt. 1, Box 157

Senatobia, MS 38868

Date
 D 2055
 9-1-81

9-1 19 81 date well completed
 Senatobia, MS 38868
 Tatt county well located


LANDOWNER: <u>W.E. Newson</u>	description of formations encountered	from	to
<u>Rt. 4</u>			
<u>Coldwater, Ms.</u> (mailing address)	<u>Red Clay</u>	<u>0</u>	<u>20</u>
	<u>Red Sand</u>	<u>20</u>	<u>60</u>
WELL LOCATION: sec <u>20</u> T <u>4</u> N R <u>5</u> E <u>1/2</u> miles <u>NW</u> of <u>Wald Hill</u> (distance) (direction) (nearest town)	<u>White Clay Sand</u>	<u>60</u>	<u>110</u>
	<u>White Sand</u>	<u>110</u>	<u>137</u>
WELL PURPOSE: <u>Home</u> (home, irrigation, municipal, industrial)			
WELL COMPLETION DATA: (1) diameter (inches) <u>4</u>			
(2) total depth (feet) <u>137</u>			
(3) static water level (feet) <u>60</u> below above top of ground.			
(4) casing <u>PVC, 137</u> (material) (depth)			
<u>7</u> If telescope see back. (size)			
(5) screen <u>7</u> <u>130</u> (length) (depth to top)			
<u>4"</u> <u>gravel type</u> (size) (material)			
(6) pump <u>1/2</u> <u>10</u> (HP) (yield gpm)			
<u>220V</u> (type power)			
(7) electric log <u>No</u> (yes or no)			
(organization running log)			
(8) how well bottom plugged <u>Cap</u>			

DRILLERS REMARKS:

RECEIVED
 SEP 24 1981
 DEPT. OF NATURAL RESOURCES
 BUREAU OF LAND & WATER RESOURCES

If well telescopes please sketch and show depths.

GROUND LEVEL

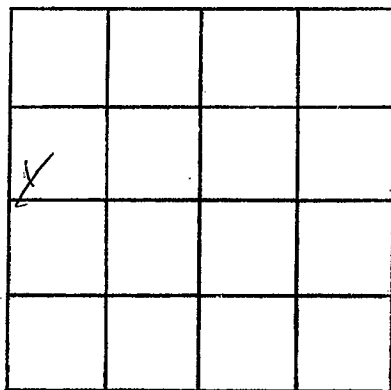

SECTION 20

Please indicate well location X.

ADDITIONAL INFORMATION

If more than one screen,
show locations of each on sketch.