

MISSISSIPPI DEPARTMENT OF NATURAL RESOURCES

Bureau of Land and Water Resources

Southport Mall

P.O. Box 10631

Jackson, Mississippi 39209

WATER WELL DRILLERS LOG

TATE
D 2056
7-17-81

7-17 19 81 Hicks Well Co. Tate  
 date well completed firm name county well located

LANDOWNER: <u>Baldrey Wagon</u> <u>Rt. 2</u>	description of formations encountered	from	to
<u>Calhoun, Mo.</u> (mailing address)			
	<u>Red Clay</u>	<u>0</u>	<u>10</u>
	<u>Red Sand</u>	<u>10</u>	<u>65</u>

WELL LOCATION:  
 sec. 33T 4 N R. 5 E  
1 miles E of Beth  
 (distance) (direction) (nearest town)

<del>Blue Clay</del>	<u>65</u>	<u>110</u>
<u>Blue Clay &amp; Red Clay</u>		
<u>White Sand</u>	<u>110</u>	<u>150</u>

WELL PURPOSE: Home  
 (home, irrigation, municipal, industrial)

WELL COMPLETION DATA:

(1) diameter (inches) 4

(2) total depth (feet) 150

(3) static water level (feet) 80 below above top of ground.


(4) casing PVC, 150  
 (material) (depth)  
 (size) If telescope see back.

(5) screen 12, 138  
 (length) (depth to top)  
4", gravel + PVC  
 (size) (material)

(6) pump 1/2, 10  
 (HP) (yield gpm)  
220V  
 (type power)

(7) electric log No  
 (yes or no)  
 (organization running log)


(8) how well bottom plugged Cap

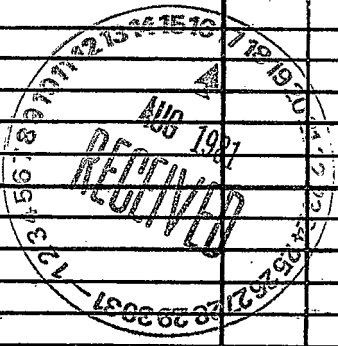

DRILLERS REMARKS:

If well telescopes please sketch and show depths.

GROUND LEVEL

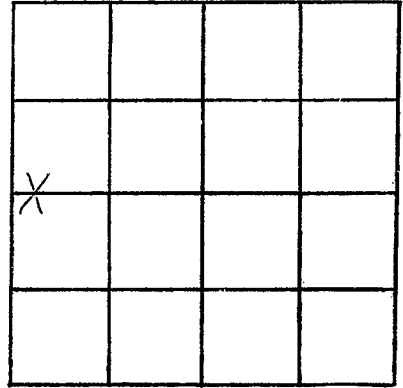

SECTION 33

Please indicate well location X.

ADDITIONAL INFORMATION

If more than one screen,  
show locations of each on sketch.