

MISSISSIPPI DEPARTMENT OF NATURAL RESOURCES

Bureau of Land and Water Resources

Southport Mall

P.O. Box 10631

Jackson, Mississippi 39209

WATER WELL DRILLERS LOG

TATE
D 2057
11-9-81

11-9-81

HICKS WELL COMPANY

Tate

date well completed

Drillers Name

county well located

LANDOWNER: Kenny Wilkita
Rt. 4 Box 152 A
Salwater, Mo.
(mailing address) 38618

| description of formations encountered | from | to |
|---------------------------------------|-----------|-----------|
| <u>Red clay</u> | <u>0</u> | <u>10</u> |
| <u>Red Sand + Clay</u> | <u>10</u> | <u>70</u> |

WELL LOCATION:
sec. 29 T. 3 N. R. 5 E. W
1 miles N of Beth
(distance) (direction) (nearest town)

| | | |
|--------------------------|-----------|------------|
| <u>White Sand + Clay</u> | <u>70</u> | <u>85</u> |
| <u>White Sand</u> | <u>85</u> | <u>130</u> |

WELL PURPOSE: Home
(home, irrigation, municipal, industrial)

WELL COMPLETION DATA:

- (1) diameter (inches) 4
- (2) total depth (feet) 130
- (3) static water level (feet) 60 below above top of ground.
- (4) casing PVC 130
(material) (depth)
— if telescope see back.
(size)
- (5) screen 17 123
(length) (depth to top)
4" PVC
(size) (material)
- (6) pump 1/2 10
(HP) (yield gpm)
220V
(type power)
- (7) electric log No
(yes or no)
- (organization running log)
- (8) how well bottom plugged Cap

DRILLERS REMARKS:


DEPT. OF NATURAL RESOURCES
BUREAU OF LAND & WATER RESOURCES

NOV 30 1981

RECEIVED

If well telescopes please sketch and show depths.

GROUND LEVEL

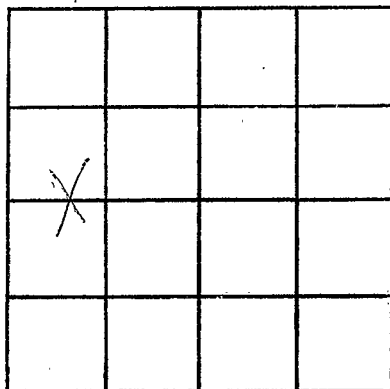

SECTION 29

Please indicate well location X.

ADDITIONAL INFORMATION

If more than one screen,
show locations of each on sketch.