

MISSISSIPPI DEPARTMENT OF NATURAL RESOURCES

Bureau of Land and Water Resources

Southport Mall

P.O. Box 10631

Jackson, Mississippi 39209

WATER WELL DRILLERS LOG

*JATE*

**TATE**  
**D 2058**  
**11-3-81**

**11-3-81** 19  
 date well completed

*Bob Smith*  
 firm name

*[Signature]*  
 county well located

LANDOWNER:  
*Leslie Betman*  
*Wakefield, Mo.*  
 (mailing address)

description of formations encountered	from	to
<i>top soil</i>	<i>0</i>	<i>5</i>
<i>red clay</i>	<i>5</i>	<i>40</i>
<i>gravel</i>	<i>40</i>	<i>90</i>
<i>white sand</i>	<i>90</i>	<i>120</i>

WELL LOCATION:  
 sec. 9 T 4 N R 5 E  
 (S) (W)  
3 miles North of Wakefield  
 (distance) (direction) (nearest town)

WELL PURPOSE:  
 (home, irrigation, municipal, industrial)

WELL COMPLETION DATA:

(1) diameter (inches) 4 1/2

(2) total depth (feet) 120'

(3) static water level (feet) 90' below above top of ground.

(4) casing plastic 120'  
 (material) (depth)

\_\_\_\_\_ if telescope see back.  
 (size)

(5) screen 10', 110'  
 (length) (depth to top)  
4 1/2, plastic  
 (size) (material)

(6) pump 1/2 10  
 (HP) (yield gpm)  
elec.  
 (type power)

(7) electric log (yes or no)  
 (organization running log)

(8) how well bottom plugged Cap.

DEPT. OF NATURAL RESOURCES  
 BUREAU OF LAND & WATER RESOURCES


SEP -7 1982

**RECEIVED**

DRILLERS REMARKS:

If well telescopes please sketch and show depths.

GROUND LEVEL

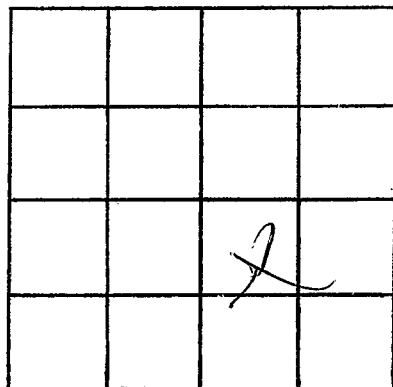

SECTION \_\_\_\_\_

Please indicate well location X.

ADDITIONAL INFORMATION

If more than one screen,  
show locations of each on sketch.