

MISSISSIPPI DEPARTMENT OF NATURAL RESOURCES

Bureau of Land and Water Resources

Southport Mall

P.O. Box 10631

Jackson, Mississippi 39209

WATER WELL DRILLERS LOG

HICKS WELL CO.

Rt. 1, Box 157

Senatobia, MS 38668

Date
D 2059

8-20 1982
date well completed

Tate
county well located

LANDOWNER: <u>Dorsey Williams</u> <u>Pt. 3</u>	description of formations encountered	from	to
<u>Caldwater, Miss. 38618</u> (mailing address)			
WELL LOCATION: sec. <u>19</u> T. <u>4</u> N. R. <u>5</u> E <u>2</u> miles <u>NE</u> of <u>Independence</u> (distance) (direction) (nearest town)	<u>Red Clay</u>	<u>0</u>	<u>10</u>
WELL PURPOSE: <u>Home</u> (home, irrigation, municipal, industrial)	<u>Red sand + Clay</u>	<u>10</u>	<u>80</u>
WELL COMPLETION DATA: (1) diameter (inches) <u>4</u>	<u>White clay</u>	<u>80</u>	<u>125</u>
(2) total depth (feet) <u>215</u>	<u>White sand</u>	<u>125</u>	<u>140</u>
(3) static water level (feet) <u>80</u> <u>below</u> top of ground.	<u>White clay</u>	<u>140</u>	<u>150</u>
(4) casing <u>PVC</u> , <u>215</u> (material) (depth)	<u>P-Dravel</u>	<u>150</u>	<u>155</u>
<u>4"</u> (size) if telescope see back.	<u>White clay</u>	<u>155</u>	<u>185</u>
(5) screen <u>10'</u> , <u>205'</u> (length) (depth to top)	<u>White sand</u>	<u>185</u>	<u>215</u>
<u>0.13</u> , <u>PVC</u> (size) (material)			
(6) pump <u>1/2</u> , <u>10</u> (HP) (yield gpm)			
<u>220V</u> (type power)			
(7) electric log <u>No</u> (yes or no)			
(organization running log)			
(8) how well bottom plugged <u>Cap</u>			

DEPT. OF NATURAL RESOURCES
BUREAU OF LAND & WATER RESOURCES


AUG 27 1982

RECEIVED

DRILLERS REMARKS:

If well telescopes please sketch and show depths.

GROUND LEVEL

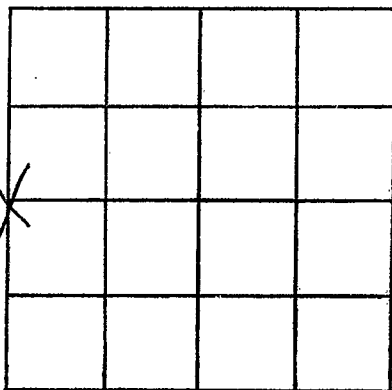

SECTION 19

Please indicate well location X.

ADDITIONAL INFORMATION

If more than one screen,
show locations of each on sketch.