

MISSISSIPPI DEPARTMENT OF NATURAL RESOURCES

Bureau of Land and Water Resources

Southport Mall

P.O. Box 10631

Jackson, Mississippi 39209

WATER WELL DRILLERS LOG

Date D 5000

9-2 1982 date well completed

HICKS WELL CO  
Rt. 1, Box 157

Tate county well located

LANDOWNER: W.L. Wallace Jr.  
P.O. Box 663  
Senatobia, Miss 38668  
(mailing address)

description of formations encountered

from to

WELL LOCATION:  
sec. 18 T. 4 N. R. 5 E  
1/4 miles S of Wakefield  
(distance) (direction) (nearest town)

Red Clay	0	20
Red sand	20	55
White sand & clay	55	140
White sand	140	173

WELL PURPOSE: Home  
(home, irrigation, municipal, industrial)

WELL COMPLETION DATA:  
(1) diameter (inches) 4  
(2) total depth (feet) 173  
(3) static water level (feet) 90 below above top of ground.  
(4) casing PVC, 173,  
(material) (depth)  
4"  
(size) If telescope see back.  
(5) screen 10', 163  
(length) (depth to top)  
013, PVC  
(size) (material)  
(6) pump 1/2 (HP) 10 (yield gpm)  
220V  
(type power)  
(7) electric log No  
(yes or no)  
(organization running log)  
(8) how well bottom plugged Cap

DEPT. OF NATURAL RESOURCES  
BUREAU OF LAND & WATER RESOURCES


SEP 20 1982

RECEIVED

DRILLERS REMARKS:

If well telescopes please sketch and show depths.

GROUND LEVEL

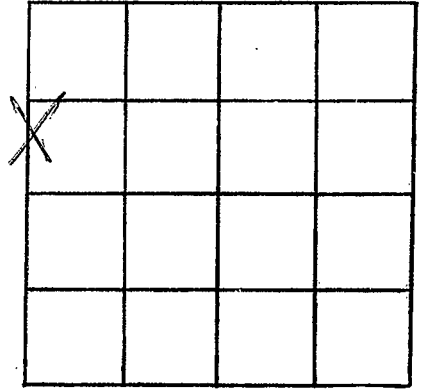

SECTION 18

Please indicate well location X.

ADDITIONAL INFORMATION

Lined area for additional information.

If more than one screen, show locations of each on sketch.