

MISSISSIPPI DEPARTMENT OF NATURAL RESOURCES

Bureau of Land and Water Resources

Southport Mall

P.O. Box 10631

Jackson, Mississippi 39209

WATER WELL DRILLERS LOG

Date  
 D 2001

3/26/82 19 *Bill Smith* *Tate*  
 date well completed firm name county well located

LANDOWNER:	description of formations encountered	from	to
<i>Victory Baptist Church</i>	<i>top soil</i>	<i>0</i>	<i>5</i>
<i>Calad Hill, Dg.</i>	<i>red clay</i>	<i>5</i>	<i>29</i>
(mailing address)	<i>gravel</i>	<i>39</i>	<i>60</i>
	<i>white clay</i>	<i>60</i>	<i>133</i>
	<i>sand</i>	<i>133</i>	<i>200</i>

WELL LOCATION:  
 sec. *28* T-*4* N R-*5* E  
*8* miles *E.* of *Chd.*  
 (distance) (direction) (nearest town)

WELL PURPOSE:  
 (home, irrigation, municipal, industrial)

WELL COMPLETION DATA:

(1) diameter (inches) *4"*

(2) total depth (feet) *200'*

(3) static water level (feet) *80'*  below  above top of ground.

(4) casing *200'*  
 (material) (depth)

\_\_\_\_\_ if telescope see back.  
 (size)

(5) screen *20'* *180'*  
 (length) (depth to top)

*1/2"* \_\_\_\_\_  
 (size) (material)

(6) pump \_\_\_\_\_  
 (HP) (yield gpm)

*elec.*  
 (type power)

(7) electric log \_\_\_\_\_  
 (yes or no)

\_\_\_\_\_ (organization running log)

(8) how well bottom plugged *cap*

DEPT. OF NATURAL RESOURCES  
 BUREAU OF LAND & WATER RESOURCES


OCT 12 1982

RECEIVED

DRILLERS REMARKS:

If well telescopes please sketch and show depths.

GROUND LEVEL

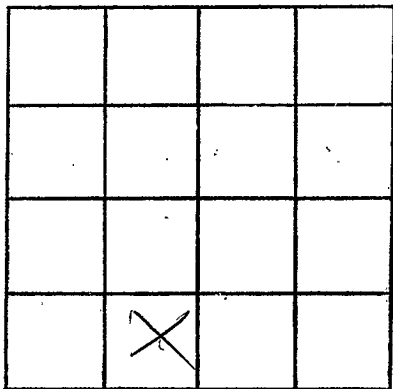

SECTION \_\_\_\_\_

Please indicate well location X.

ADDITIONAL INFORMATION

If more than one screen,  
show locations of each on sketch.