

MISSISSIPPI DEPARTMENT OF NATURAL RESOURCES

Bureau of Land and Water Resources

Southport Mall

P.O. Box 10631

Jackson, Mississippi 39209

WATER WELL DRILLERS LOG

Date
 Done

5-13-80 date well completed

Bob Smith firm name

state county well located

LANDOWNER:

John L. Green
 Independence, Mo.
 (mailing address)

description of formations encountered

from to

top soil 0 5
 rd clay 5 18
 white clay 18 72
 sand 72 160

WELL LOCATION:

sec 28 T 4 N R 5 E
 S W
 8 miles E of Chd.
 (distance) (direction) (nearest town)

WELL PURPOSE:

(home, irrigation, municipal, industrial)

WELL COMPLETION DATA:

- (1) diameter (inches) 4"
- (2) total depth (feet) 160'
- (3) static water level (feet) 90' below top of ground.

(4) casing plastic 160'
 (material) (depth)

(size) if telescope see back.

(5) screen 10' 150'
 (length) (depth to top)

4" plastic
 (size) (material)

(6) pump 1/2 10
 (HP) (yield gpm)

elec.
 (type power)

(7) electric log (yes or no)

(organization running log)

(8) how well bottom plugged Cap

DRILLERS REMARKS:


DEPT. OF NATURAL RESOURCES
 BUREAU OF LAND & WATER RESOURCES

OCT 12 1982

RECEIVED

If well telescopes please sketch and show depths.

GROUND LEVEL

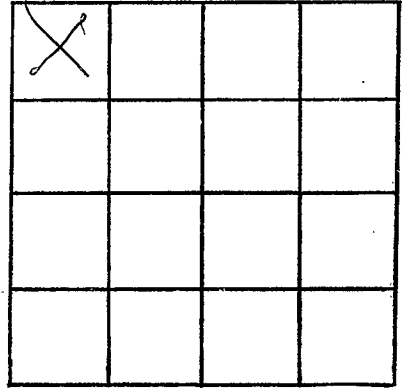

SECTION _____

Please indicate well location X.

ADDITIONAL INFORMATION

If more than one screen,
show locations of each on sketch.