

MISSISSIPPI DEPARTMENT OF NATURAL RESOURCES
Bureau of Land and Water Resources
 Southport Mall
 P.O. Box 10631
 Jackson, Mississippi 39209
WATER WELL DRILLERS LOG

Date Dec 3

Tate

date well completed 9-3 1982

HICKS WELL CO.
 Rt. 14 Box 107
 Senatobia MS 38668

county well located _____

LANDOWNER: Jama Patrick
Rt. 2
Caldwate, Miss
 (mailing address)

description of formations encountered	from	to
Red clay	0	15
Red Sand + Gravel	15	100
white sand	100	150

WELL LOCATION:
 sec. 31 T. 4 N. R. 5 E. of Pitt
 (distance) miles (direction) (nearest town)

WELL PURPOSE: Home
 (home, irrigation, municipal, industrial)

- WELL COMPLETION DATA:
- (1) diameter (inches) 4"
 - (2) total depth (feet) 150
 - (3) static water level (feet) 60 ^{below} _{above} top of ground.
 - (4) casing PVC (material), (depth) 4" (size) If telescope see back.
 - (5) screen 10' (length), (depth to top) 013 (size), PVC (material)
 - (6) pump 1/2 (HP), 10 (yield gpm), 220V (type power)
 - (7) electric log No (yes or no)

(organization running log) _____

(8) how well bottom plugged Cap

DRILLERS REMARKS: _____


DEPT. OF NATURAL RESOURCES
 BUREAU OF LAND & WATER RESOURCES

OCT 14 1982

RECEIVED

If well telescopes please sketch and show depths.

GROUND LEVEL

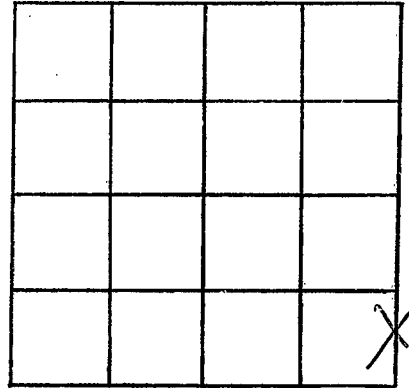

SECTION 31

Please indicate well location X.

ADDITIONAL INFORMATION

Lined area for additional information.

If more than one screen, show locations of each on sketch.