

MISSISSIPPI DEPARTMENT OF NATURAL RESOURCES

Bureau of Land and Water Resources

Southport Mall

P.O. Box 10631

Jackson, Mississippi 39209

WATER WELL DRILLERS LOG

HICKS WELL CO.

P.O. Box 157

Senatobia, MS 38668

Date  
 \_\_\_\_\_  
 \_\_\_\_\_  
 \_\_\_\_\_  
 \_\_\_\_\_

3-23 1983  
 date well completed

Tata  
 county well located

LANDOWNER: Elaine Thomson  
 P.O. Box 254A  
 Caldwell, Ms.  
 (mailing address) 38618

description of formations encountered	from	to
Red Clay	0	20
Red Sand	20	50
White Sand	50	90
White Sand + Clay	90	125
White Sand	125	140

WELL LOCATION:  
 sec. 9 T 4 N R 5 E  
 7 miles E of Wakefield  
 (distance) (direction) (nearest town)

WELL PURPOSE: Home  
 (home, irrigation, municipal, industrial)

- WELL COMPLETION DATA:
- (1) diameter (inches) 4
  - (2) total depth (feet) 140
  - (3) static water level (feet) 80 below top of ground.
  - (4) casing PVC, 140 (material), (depth)  
 4" (size) if telescope see back.
  - (5) screen 10', 130 (length), (depth to top)  
 013, PVC (size), (material)
  - (6) pump 1/2, 10 (HP), (yield gpm)  
 220V (type power)
  - (7) electric log No (yes or no)  
 (organization running log)
  - (8) how well bottom plugged Cap

DRILLERS REMARKS:  
 \_\_\_\_\_  
 \_\_\_\_\_  
 \_\_\_\_\_


DEPT. OF NATURAL RESOURCES  
 BUREAU OF LAND & WATER RESOURCES

APR - 4 1993

RECEIVED

If well telescopes please sketch and show depths.

GROUND LEVEL

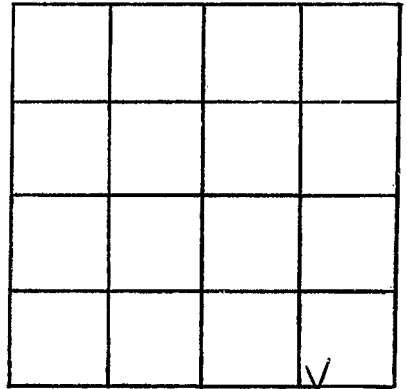

SECTION 9

Please indicate well location X.

ADDITIONAL INFORMATION

If more than one screen,  
show locations of each on sketch.