

MISSISSIPPI DEPARTMENT OF NATURAL RESOURCES
Bureau of Land and Water Resources
Southport Mall
P.O. Box 10631
Jackson, Mississippi 39209
WATER WELL DRILLERS LOG

Date
Dec 20 1983

3-31 1983 HICKS WELL CO. Tate
date well completed Rt. 1, Box 107 county well located
Sanatobia, MS 39066

LANDOWNER: Robert Webb description of formations encountered from to
Pl. 2
Caldwell, No. 53861R Red clay 0 15
(mailing address) Red sand 15 35

WELL LOCATION:
sec. 31 T. 4 N. R. 5 E
S W
— miles — of Beth
(distance) (direction) (nearest town)
White clay sand 35 65
White sand 65 135


WELL PURPOSE: Home
(home, irrigation, municipal, industrial)

WELL COMPLETION DATA:
(1) diameter (inches) 4
(2) total depth (feet) 135
(3) static water level (feet) 20 ^{below} above top of ground.
(4) casing PVC, 135
(material) (depth)
4"
(size) If telescope see back.
(5) screen 10', 125'
(length) (depth to top)
5/8", PVC
(size) (material)
(6) pump 1/2, 10
(HP) (yield gpm)
220V
(type power)
(7) electric log Yes
(yes or no)
(organization running log)
(8) how well bottom plugged Cap

DRILLERS REMARKS:
APR - 4 1983
RECEIVED

If well telescopes please sketch and show depths.

GROUND LEVEL

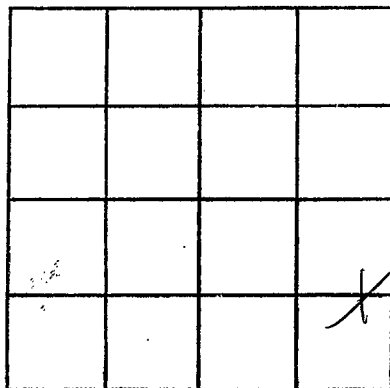

SECTION 31

Please indicate well location X.

ADDITIONAL INFORMATION

If more than one screen,
show locations of each on sketch.