

MISSISSIPPI DEPARTMENT OF NATURAL RESOURCES
Bureau of Land and Water Resources
 Southport Mall
 P.O. Box 10631
 Jackson, Mississippi 39209
WATER WELL DRILLERS LOG

Date _____

6-20 1983 **NICKS WELL CO.** *Tate*
 date well completed firm name county well located
 Senatobia MS 38660

LANDOWNER: Thomas Danell
Rt. 4 Box 232
Caldwate, Miss.
 (mailing address) 38618

description of formations encountered	from	to
Red Clay	0	20
Gravel + Sand	20	65
Red Sand	65	110
White Sand	110	125
White Sand + Clay	125	140
White Sand	140	160

WELL LOCATION:
 sec. 6 T. 4 N. R. 5 E.
1/2 miles NNE of Wakfield
 (distance) (direction) (nearest town)

WELL PURPOSE: Home
 (home, irrigation, municipal, industrial)


- WELL COMPLETION DATA:
- (1) diameter (inches) 4
 - (2) total depth (feet) 160
 - (3) static water level (feet) 100 below above top of ground.
 - (4) casing PVC, 160,
 (material) (depth)
4"
 (size) If telescope see back.
 - (5) screen 10', 150'
 (length) (depth to top)
.013, PVC
 (size) (material)
 - (6) pump 1, 18
 (HP) (yield gpm)
220V
 (type power)
 - (7) electric log No
 (yes or no)
 (organization running log)
 - (8) how well bottom plugged Cap

DRILLERS REMARKS:

DEPT. OF NATURAL RESOURCES
 BUREAU OF LAND & WATER RESOURCES
 JUN 27 1983
RECEIVED

If well telescopes please sketch and show depths.

GROUND LEVEL

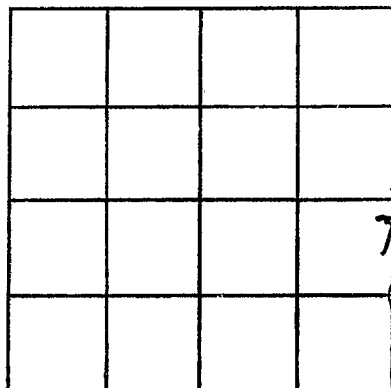

SECTION 6

Please indicate well location X.

ADDITIONAL INFORMATION

If more than one screen, show locations of each on sketch.