

MISSISSIPPI DEPARTMENT OF NATURAL RESOURCES

Bureau of Land and Water Resources

Southport Mall

P.O. Box 10631

Jackson, Mississippi 39209

WATER WELL DRILLERS LOG

Date
December

4-6 1983 Gullett Well Drilling Tate
 date well completed firm name county well located

LANDOWNER: Ralph Darnell
Rt. 3 Box 357
Coldwater, Ms. 38618
 (mailing address)

description of formations encountered	from	to
<u>Top Soil</u>	<u>0</u>	<u>10</u>
<u>Red clay</u>	<u>10</u>	<u>30</u>
<u>Sand and clay</u>	<u>30</u>	<u>130</u>

WELL LOCATION:
 sec. 8 T. 4 N. R. 5 E. S. 1 W.
2 miles North of Wokefield
 (distance) (direction) (nearest town)

WELL PURPOSE: Home
 (home, irrigation, municipal, industrial)

WELL COMPLETION DATA:

- (1) diameter (inches) 4"
- (2) total depth (feet) 130'
- (3) static water level (feet) 85' below above top of ground.
- (4) casing 160 PVC, 130'
 (material) (depth)
4" if telescope see back.
 (size)
- (5) screen 10' (length) (depth to top)
4" (size) 160 PVC (material)
- (6) pump 1/2 (HP) 10 (yield gpm)
electric (type power)
- (7) electric log _____
 (yes or no)

 (organization running log)
- (8) how well bottom plugged Cap

DRILLERS REMARKS:


DEPT. OF NATURAL RESOURCES
 BUREAU OF LAND & WATER RESOURCES

JUN 21 1983

RECEIVED

If well telescopes please
sketch and show depths.

GROUND LEVEL

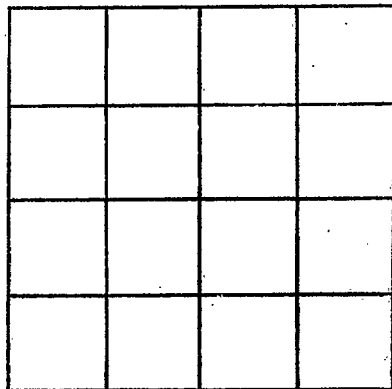

SECTION _____

Please indicate well location X.

ADDITIONAL INFORMATION

If more than one screen,
show locations of each on sketch.