

MISSISSIPPI DEPARTMENT OF NATURAL RESOURCES

Bureau of Land and Water Resources

Southport Mall

P.O. Box 10631

Jackson, Mississippi 39209

WATER WELL DRILLERS LOG

Date
 Dec 2009

7-11-83
 date well completed

HICKS WELL LOG
 RE. H. H. H. CO.
 Rt. 1, Box 157

Tato
 county well located

LANDOWNER: <u>Martin Burton</u>	description of formations encountered	from	to
<u>Rt. 4</u>	<u>Red clay</u>	<u>0</u>	<u>15</u>
<u>Caldwater, Mo. 38618</u> (mailing address)	<u>Red sand</u>	<u>15</u>	<u>60</u>
WELL LOCATION: sec. <u>17</u> T <u>4</u> N R. <u>5</u> E 1 miles <u>N</u> of <u>Wall Hill</u> (distance) (direction) (nearest town)	<u>White sand</u>	<u>60</u>	<u>130</u>
WELL PURPOSE: <u>Home</u> (home, irrigation, municipal, industrial)			
WELL COMPLETION DATA: (1) diameter (inches) <u>4</u> (2) total depth (feet) <u>130</u> (3) static water level (feet) <u>100</u> ^{below} _{above} top of ground. (4) casing <u>PVC</u> , <u>130</u> (material) (depth) <u>4"</u> (size) if telescope see back. (5) screen <u>10'</u> , <u>120'</u> (length) (depth to top) <u>1/2</u> , <u>PVC</u> (size) (material) (6) pump <u>1/2</u> <u>10</u> (HP) (yield gpm) <u>220V</u> (type power) (7) electric log <u>No</u> (yes or no) (organization running log) (8) how well bottom plugged <u>Cap</u>			
DRILLERS REMARKS:			


DEPT. OF NATURAL RESOURCES
 BUREAU OF LAND & WATER RESOURCES

AUG 11 1983

RECEIVED

If well telescopes please sketch and show depths.

GROUND LEVEL

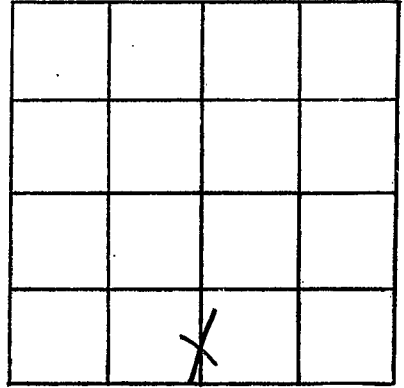

SECTION 17

Please indicate well location X.

ADDITIONAL INFORMATION

If more than one screen, show locations of each on sketch.