

MISSISSIPPI DEPARTMENT OF NATURAL RESOURCES

Bureau of Land and Water Resources

Southport Mall

P.O. Box 10631

Jackson, Mississippi 39209

WATER WELL DRILLERS LOG

Date  
Daoro

2/29 19 84  
 date well completed

HICKS WELL CO.  
 Rt. 1, Box 157  
 Senatobia, MS 38668  
 firm name

Tate  
 county well located

LANDOWNER: Robert Muph  
Rt. 4  
Caldwate, Mo. 38618  
 (mailing address)

description of formations encountered	from	to
<u>Red Clay</u>	<u>0</u>	<u>20</u>
<u>Red Sand</u>	<u>20</u>	<u>60</u>

WELL LOCATION:  
 sec. 24 4 N 5 E  
9 W  
 miles of Wall Hill  
 (distance) (direction) (nearest town)

<u>White Clay &amp; Sand</u>	<u>60</u>	<u>118</u>
<u>White Sand</u>	<u>110</u>	<u>130</u>

WELL PURPOSE: Home  
 (home, irrigation, municipal, industrial)

WELL COMPLETION DATA:

(1) diameter (inches) 4

(2) total depth (feet) 130

(3) static water level (feet) 80 above top of ground.

(4) casing PVC, 130  
 (material) (depth)  
4" If telescope see back.  
 (size)

(5) screen 10', 120'  
 (length) (depth to top)  
0.13, PVC  
 (size) (material)

(6) pump 1/2 10  
 (HP) (yield gpm)  
2250  
 (type power)

(7) electric log No  
 (yes or no)

(8) how well bottom plugged Cap  
 (organization running log)

DRILLERS REMARKS:


DEPT. OF NATURAL RESOURCES  
 BUREAU OF LAND & WATER RESOURCES

MAR 19 1984

RECEIVED

If well telescopes please sketch and show depths.

GROUND LEVEL

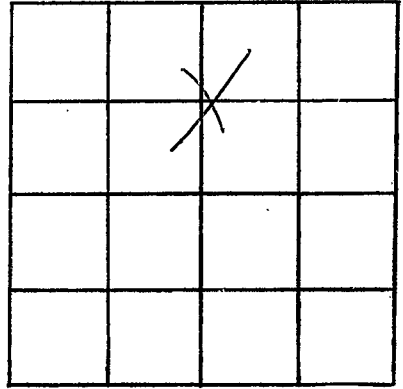

SECTION 20

Please indicate well location X.

ADDITIONAL INFORMATION

If more than one screen,  
show locations of each on sketch.