

MISSISSIPPI DEPARTMENT OF NATURAL RESOURCES

Bureau of Land and Water Resources

Southport Mall

P.O. Box 10631

Jackson, Mississippi 39209

WATER WELL DRILLERS LOG

TATE
LD
200

6-15 1984  
date well completed

HICKS WELL CO.  
firm Home DUX 157  
Seratobia MS 39668

Tate  
county well located

LANDOWNER:	description of formations encountered	from	to
Mary Langston P.O. 4			
Coldwater, Mo. 38618 (mailing address)	Red Clay	0	20
	Red Sand	20	60
	Gravel	60	70
	White Sand	70	135

WELL LOCATION:  
sec. 20 T 4 N R 5 E  
2 miles SE of Wakefield  
(distance) (direction) (nearest town)

WELL PURPOSE: home  
(home, irrigation, municipal, industrial)

WELL COMPLETION DATA:


- (1) diameter (inches) 4
- (2) total depth (feet) 135
- (3) static water level (feet) 100 <sup>below</sup> <sub>above</sub> top of ground.
- (4) casing PVC, 135  
(material), (depth)  
4"  
(size) If telescope see back.
- (5) screen 10', 125'  
(length), (depth to top)  
1010, PVC  
(size), (material)
- (6) pump 1/2, 10  
(HP), (yield gpm)  
220V  
(type power)
- (7) electric log No  
(yes or no)  
(organization running log)
- (8) how well bottom plugged Caps

DRILLERS REMARKS:

DEPT. OF NATURAL RESOURCES  
BUREAU OF LAND & WATER RESOURCES  
JUN 10 1984  
RECEIVED

If well telescopes please sketch and show depths.

GROUND LEVEL

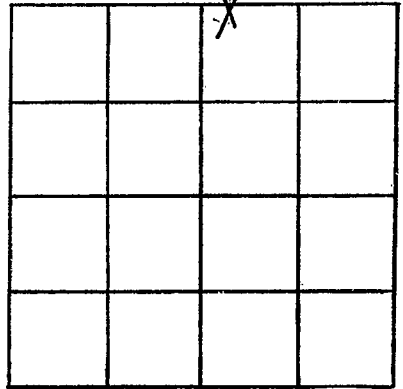

SECTION 20

Please indicate well location X.

ADDITIONAL INFORMATION

If more than one screen, show locations of each on sketch.