

MISSISSIPPI DEPARTMENT OF NATURAL RESOURCES

Bureau of Land and Water Resources

Southport Mall

P.O. Box 10631

Jackson, Mississippi 39209

WATER WELL DRILLERS LOG

HICKS WELL CO.

Rt. 1, Box 157

Semotonia, MS 38668

Date  
8-8-84

8-8-1984  
 date well completed

Tate  
 county well located

LANDOWNER: <u>Ralph McCann</u> <u>Rt. 3</u>	description of formations encountered	from	to
<u>Coldwater, Ms. 38618</u> (mailing address)	<u>Red Clay</u>	0	10
	<u>Red Sand</u>	10	30
WELL LOCATION: sec. <u>19</u> T <u>4</u> N R. <u>5</u> E <u>1 1/2</u> miles <u>N</u> of <u>Bett</u> (distance) (direction) (nearest town)	<u>white sand + clay</u>	30	100
WELL PURPOSE: <u>Home</u> (home, irrigation, municipal, industrial)	<u>white sand</u>	100	174
WELL COMPLETION DATA:			
(1) diameter (inches) <u>4</u>			
(2) total depth (feet) <u>174</u>			
(3) static water level (feet) <u>110</u> <u>below</u> top of ground.			
(4) casing <u>PVC</u> , <u>174</u> , (material) (depth) <u>4"</u> if telescope see back. (size)			
(5) screen <u>10'</u> , <u>164'</u> (length) (depth to top) <u>1810</u> , <u>PVC</u> (size) (material)			
(6) pump <u>1/2</u> , <u>10</u> (HP) (yield gpm) <u>220V</u> (type power)			
(7) electric log <u>No</u> (yes or no)			
(organization running log)			
(8) how well bottom plugged <u>Cap</u>			
DRILLERS REMARKS:			


DEPT. OF NATURAL RESOURCES  
 BUREAU OF LAND & WATER RESOURCES

SEP 24 1984

RECEIVED

If well telescopes please sketch and show depths.

GROUND LEVEL

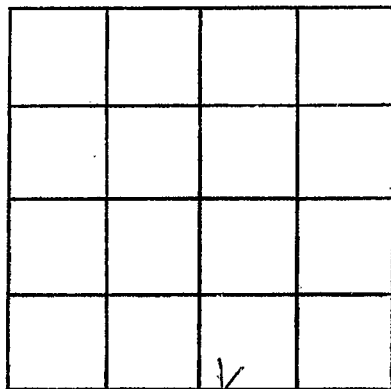

SECTION 19

Please indicate well location X.

ADDITIONAL INFORMATION

If more than one screen, show locations of each on sketch.