

MISSISSIPPI DEPARTMENT OF NATURAL RESOURCES

Bureau of Land and Water Resources

Southport Mall

P.O. Box 10631

Jackson, Mississippi 39209

WATER WELL DRILLERS LOG

HICKS WELL COMPANY

D 2073
Tate
7-10-85

7-10-1985 date well completed RT. firm name 151 county well located TATE

LANDOWNER: Leon Boyd
R#2
Coldwater MS 38818
(mailing address)

WELL LOCATION:
sec. 28 T 4 N R 5 E
2 1/2 miles NE of BETT
(distance) (direction) (nearest town)

WELL PURPOSE: Home
(home, irrigation, municipal, industrial)

WELL COMPLETION DATA:

(1) diameter (inches) 4"

(2) total depth (feet) 155'

(3) static water level (feet) 100' below top of ground.

(4) casing PVC, 145' (depth)
4" (size) if telescope see back.

(5) screen 10' (length), 145' (depth to top)
1013 (size), PVC (material)


(6) pump 1/2 (HP), 10 (yield gpm)
220 V (type power)

(7) electric log NO (yes or no)
(organization running log)

(8) how well bottom plugged Cap

description of formations encountered	from	to
Red clay	0	10
Red Sand	10	30
White clay & Sand	80	80
White Sand	80	155


DRILLERS REMARKS:

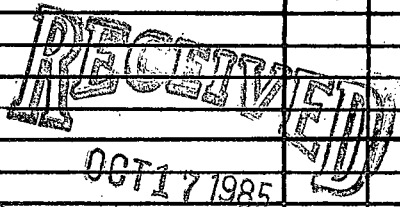

Department of Natural Resources
Bureau of Land & Water Resources

If well telescopes please sketch and show depths.

GROUND LEVEL

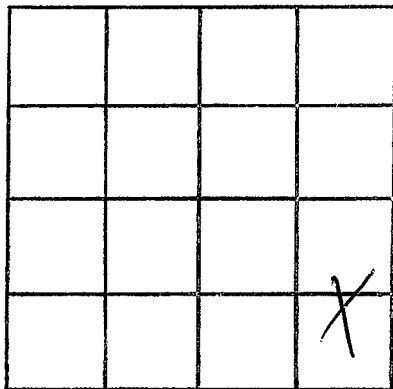

SECTION 28

Please indicate well location X.

ADDITIONAL INFORMATION

If more than one screen,
show locations of each on sketch.