

MISSISSIPPI DEPARTMENT OF NATURAL RESOURCES

Bureau of Land and Water Resources

Southport Mall

P.O. Box 10631

Jackson, Mississippi 39209

WATER WELL DRILLERS LOG

Tate
D 2074
5-13-85

HICKS WELL COMPANY

Tate

5-13 19 85
date well completed

RT. 1 Firm Name 157

county well located

SENATORIA, MISS.

LANDOWNER: J.L. Maliken

description of formations encountered

from

to

Rt # 4 Box 249

Red Clay

0

10

Caldwater MS 38618

Red Sand

10

50

(mailing address)

White Sand & clay

50

80

WELL LOCATION:

White Sand

80

140

sec. 17 T. 4 N. R. 5 E
S SW W
2 miles EAST of Wakefield
(distance) (direction) (nearest town)

WELL PURPOSE: HOME
(home, irrigation, municipal, industrial)

WELL COMPLETION DATA:

- (1) diameter (inches) 4"
- (2) total depth (feet) 140'
- (3) static water level (feet) 100' below top of ground.
- (4) casing PVC, 130' (depth)
4" (size) if telescope see back.
- (5) screen 10' (length), 130' (depth to top)
1/2" (size), PVC (material)
- (6) pump 1/2 (HP), 10 (yield gpm)
220 V (type power)
- (7) electric log NO (yes or no)

(organization running log)

(8) how well bottom plugged Cap

RECEIVED


JUL 1 - 1985

DRILLERS REMARKS:

Department of Natural Resources
Bureau of Land & Water Resources

If well telescopes please sketch and show depths.

GROUND LEVEL

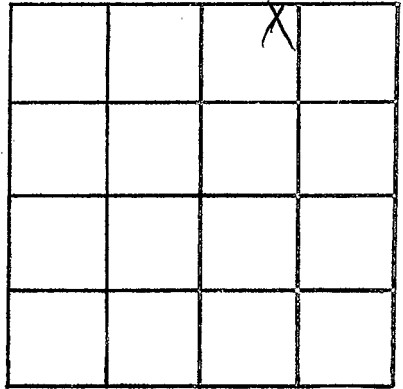

SECTION 17

Please indicate well location X.

ADDITIONAL INFORMATION

If more than one screen,
show locations of each on sketch.