

MISSISSIPPI DEPARTMENT OF NATURAL RESOURCES

Bureau of Land and Water Resources

Southport Mall

P.O. Box 10631

Jackson, Mississippi 39209

WATER WELL DRILLERS LOG

HICKS WELL COMPANY

Tate

D 2075
Tate
7-12-85

7-12-19 85
date well completed

Rt. firm name 157

county well located

LANDOWNER: Ed Marray

description of formations encountered

from to

R #2

Red clay

0 10

Cold water MS 38818
(mailing address)

Red Sand + Gravel

10 30

WELL LOCATION:

sec. 22 T 4 N R 5 E
S W
2 1/2 miles NE of Bert
(distance) (direction) (nearest town)

White Sand

30 140

WELL PURPOSE: Home
(home, irrigation, municipal, industrial)

WELL COMPLETION DATA:

- (1) diameter (inches) 4"
- (2) total depth (feet) 140'
- (3) static water level (feet) 100' below top of ground.
- (4) casing PVC, 130' (depth)
4" (size) if telescope see back.
- (5) screen 10' (length), 130' (depth to top)
.013 (size), PVC (material)
- (6) pump 1/2 (HP), 10 (yield gpm)
220 V (type power)
- (7) electric log No (yes or no)

(organization running log)

(8) how well bottom plugged Cap


DRILLERS REMARKS:

RECEIVED

OCT 17 1985

If well telescopes please sketch and show depths.

GROUND LEVEL

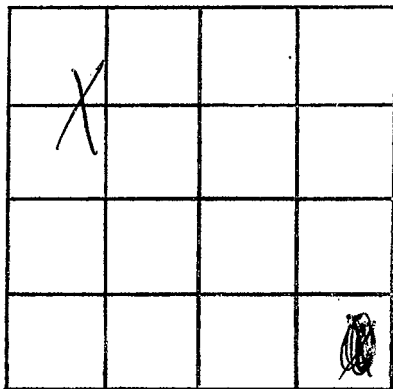

SECTION 28

Please indicate well location X.

ADDITIONAL INFORMATION

If more than one screen,
show locations of each on sketch.