

MISSISSIPPI DEPARTMENT OF NATURAL RESOURCES

Bureau of Land and Water Resources

Southport Mall

P.O. Box 10631

Jackson, Mississippi 39209

**WATER WELL DRILLERS LOG**

HICKS WELL COMPANY

D 2076  
Jake  
7-15-85

7-15 1985  
date well completed

PT. 1 BOX 157  
firm name  
SENATORIA, MISS

Tate  
county well located

LANDOWNER: Ray Freeman

description of formations encountered

from to

RT # 4 Box 297

Red Sand

0 30

Coldwater MS 38618  
(mailing address)

White Sand

30 155

WELL LOCATION:

sec. 32 T 4 N R 5 E  
⑤ ④  
1 miles E of BETT  
(distance) (direction) (nearest town)

WELL PURPOSE: HOME  
(home, irrigation, municipal, industrial)

WELL COMPLETION DATA:

- (1) diameter (inches) 4"
- (2) total depth (feet) 155'
- (3) static water level (feet) 100 below above top of ground.
- (4) casing PVC, 145',  
(material) (depth)  
4" if telescope see back.  
(size)
- (5) screen 10', 145'  
(length) (depth to top)  
.013, PVC  
(size) (material)
- (6) pump 1/2, 10  
(HP) (yield gpm)  
220 V  
(type power)
- (7) electric log NO  
(yes or no)  
(organization running log)
- (8) how well bottom plugged Cap

RECEIVED


OCT 17 1985

DRILLERS REMARKS:

Department of Natural Resources  
Bureau of Land & Water Resources

If well telescopes please sketch and show depths.

GROUND LEVEL

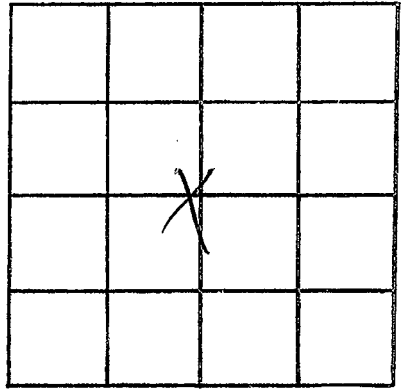

SECTION 32

Please indicate well location X.

ADDITIONAL INFORMATION

If more than one screen,  
show locations of each on sketch.