

MISSISSIPPI DEPARTMENT OF NATURAL RESOURCES

Bureau of Land and Water Resources

Southport Mall

P.O. Box 10631

Jackson, Mississippi 39209

WATER WELL DRILLERS LOG

HICKS WELL COMPANY

Tate  
 D 2078  
 1-13-85

1-13 19 85 RT 1 - BOX 157  
 date well completed firm name county well located  
 SENATOBIA, MISS.

LANDOWNER: Will Hancock  
Rt #4 Box 350A  
Caldwater MS 38618  
 (mailing address)

WELL LOCATION:  
 sec. 30 T 4 N R 5 E  
1.5 (S) (W)  
3 miles North of BETT  
 (distance) (direction) (nearest town)

WELL PURPOSE: Home  
 (home, irrigation, municipal, industrial)

WELL COMPLETION DATA:

(1) diameter (inches) 4"

(2) total depth (feet) 170'

(3) static water level (feet) 100' <sup>below</sup> above top of ground.

(4) casing PVC, 130',  
 (material) (depth)  
4" If telescope see back.  
 (size)

(5) screen 10', 130'  
 (length) (depth to top)  
1010, PVC  
 (size) (material)

(6) pump 1/2, 10  
 (HP) (yield gpm)  
220 V  
 (type power)

(7) electric log No  
 (yes or no)  
 (organization running log)

(8) how well bottom plugged Cap

description of formations encountered	from	to
Red clay	0	10
Red Sand	10	30
White clay	30	110
White Sand & Clay	110	130
White clay	130	170

RECEIVED


JUL 1 - 1985

Department of Natural Resources  
 Bureau of Land & Water Resources

DRILLERS REMARKS: It has  
30 ft of Deadman on it  
& 10 ft of screen

If well telescopes please sketch and show depths.

GROUND LEVEL

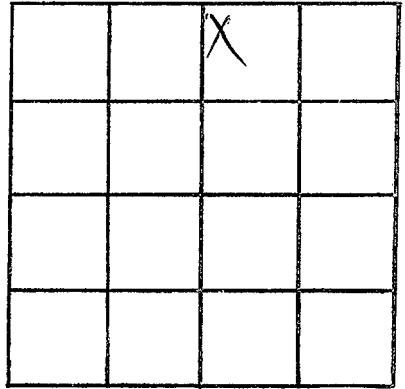

SECTION 30

Please indicate well location X.

ADDITIONAL INFORMATION

If more than one screen,  
show locations of each on sketch.