

MISSISSIPPI DEPARTMENT OF NATURAL RESOURCES

Bureau of Land and Water Resources

Southport Mall

P.O. Box 10631

Jackson, Mississippi 39209

**WATER WELL DRILLERS LOG**

HICKS WELL COMPANY

Tate
D 2079

8-14 19 85  
date well completed

PT. 1 BOX 157

Tate

firm name  
SENATOBIA, MISS.

county well located

LANDOWNER: <u>Willie B. Kelly</u> <u>1608 Easthawn Dr.</u> <u>Memphis TN 38111</u> (mailing address)	description of formations encountered	from	to
		Red clay	0
WELL LOCATION: sec. <u>20</u> T <u>4</u> N R <u>5</u> E S W <u>3</u> miles <u>NE</u> of <u>BETT</u> (distance) (direction) (nearest town)	Red Sand & Gravel	10	30
	White Sand	30	140
WELL PURPOSE: <u>Home</u> (home, irrigation, municipal, industrial)			
WELL COMPLETION DATA: (1) diameter (inches) <u>4"</u> (2) total depth (feet) <u>140'</u> (3) static water level (feet) <u>100</u> <sup>below</sup> <sub>above</sub> top of ground. (4) casing <u>PVC</u> , <u>130'</u> , (material) (depth) <u>4"</u> if telescope see back. (size) (5) screen <u>10'</u> , <u>130'</u> (length) (depth to top) <u>0.13</u> , <u>PVC</u> (size) (material) (6) pump <u>1/2</u> , <u>10</u> (HP) (yield gpm) <u>220 V</u> (type power) (7) electric log <u>NO</u> (yes or no) (organization running log) (8) how well bottom plugged <u>Cap</u>			


RECEIVED  
NOV - 1 1985

DRILLERS REMARKS:

Department of Natural Resources  
Bureau of Land & Water Resources

If well telescopes please sketch and show depths.

GROUND LEVEL

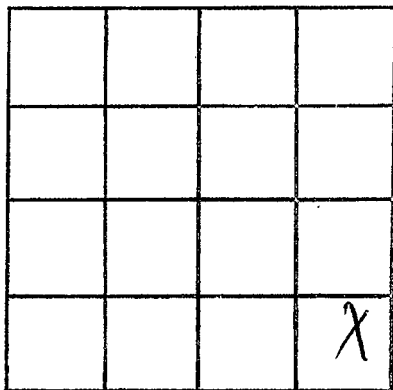

SECTION 20

Please indicate well location X.

ADDITIONAL INFORMATION

If more than one screen,  
show locations of each on sketch.