

MISSISSIPPI DEPARTMENT OF NATURAL RESOURCES

Bureau of Land and Water Resources

Southport Mall

P.O. Box 10631

Jackson, Mississippi 39209

WATER WELL DRILLERS LOG

TATE
D 2080

HICKS WELL COMPANY

Date

12-3 1985
date well completed

RT. 1 BOX 157

county well located

SENATORIA, MISS.

LANDOWNER: Alone Jones

description of formations encountered

from

to

Rt # 4

Red clay

0

10

Caldwell, MS 38618
(mailing address)

Gravel & Red sand

10

30

WELL LOCATION:

white sand

30

150

sec. 17 T 4 N R 5 E
S W

4 miles NE of Bert
(distance) (direction) (nearest town)

WELL PURPOSE: Home
(home, irrigation, municipal, industrial)

WELL COMPLETION DATA:

- (1) diameter (inches) 4"
- (2) total depth (feet) 150'
- (3) static water level (feet) 100' ^{below} _{above} top of ground.

(4) casing PVC 140'
(material) (depth)

4" if telescope see back.
(size)

(5) screen 10' 140'
(length) (depth to top)

.013 PVC
(size) (material)


(6) pump 1/2 10
(HP) (yield gpm)

2200
(type power)

(7) electric log NO
(yes or no)

(organization running log)

(8) how well bottom plugged Cap

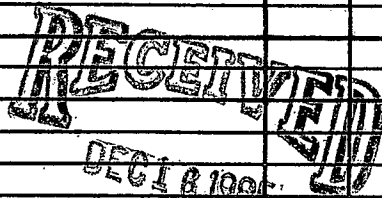


Department of Natural Resources
Bureau of Land & Water Resources

DRILLERS REMARKS:

If well telescopes please sketch and show depths.

GROUND LEVEL

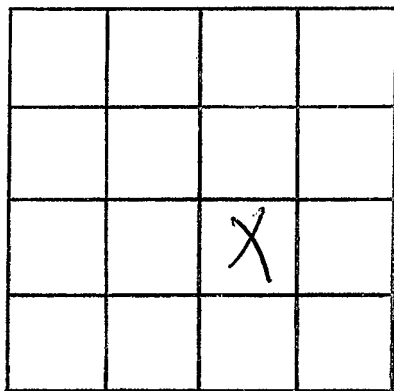

SECTION 17

Please indicate well location X.

ADDITIONAL INFORMATION

If more than one screen,
show locations of each on sketch.