

MISSISSIPPI DEPARTMENT OF NATURAL RESOURCES

Bureau of Land and Water Resources

Southport Mall

P.O. Box 10631

Jackson, Mississippi 39209

WATER WELL DRILLERS LOG

DATE
12-4-85

HICKS WELL COMPANY

12-4-1985  
date well completed

RT. 1, BOX 157

Date  
county well located

LANDOWNER: Annal Newman

description of formations encountered

from to

Rt # 4

Caldwater, MS 39618  
(mailing address)

Red clay 0 10

Shredded & Red sand 10 30

WELL LOCATION:

sec. 20 T 4 N R 05 E  
S W  
4 miles NE of Beatt  
(distance) (direction) (nearest town)

white sand 30 140

WELL PURPOSE: Home  
(home, irrigation, municipal, industrial)

WELL COMPLETION DATA:

- (1) diameter (inches) 4"
- (2) total depth (feet) 140'
- (3) static water level (feet) 100' below above top of ground.
- (4) casing PVC 130'  
(material) (depth)  
4" if telescope see back.  
(size)
- (5) screen 10' 130'  
(length) (depth to top)  
.013 PVC  
(size) (material)
- (6) pump 1/2 10  
(HP) (yield gpm)  
220 V  
(type power)
- (7) electric log NO  
(yes or no)

(organization running log)

(8) how well bottom plugged Cap


DRILLERS REMARKS:

RECEIVED  
IN  
DEC 16 1985

Department of Natural Resources  
Bureau of Land & Water Resources

If well telescopes please sketch and show depths.

GROUND LEVEL

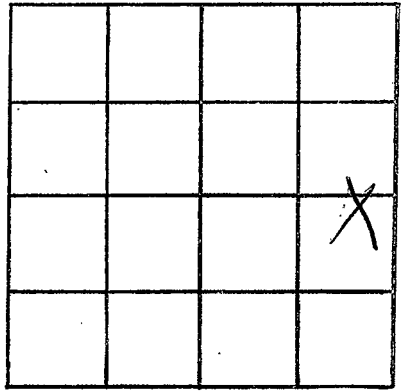

SECTION 20

Please indicate well location X.

ADDITIONAL INFORMATION

If more than one screen, show locations of each on sketch.