

MISSISSIPPI DEPARTMENT OF NATURAL RESOURCES

Bureau of Land and Water Resources

Southport Mall

P.O. Box 10631

Jackson, Mississippi 39209

WATER WELL DRILLERS LOG

TATE
D2082

7-8 1986 Gullett Water Well Marshall Late  
 date well completed firm name county well located


LANDOWNER: Mr Watson  
Rt 3 Box 336  
Coldwater, Ms  
 (mailing address)

description of formations encountered	from	to
<u>Top Soil</u>	<u>0'</u>	<u>2'</u>
<u>Red Clay</u>	<u>2'</u>	<u>20'</u>
<u>gravel Red Sand</u>	<u>20'</u>	<u>50'</u>
<u>White sand clay</u>	<u>50'</u>	<u>110'</u>
<u>White Sand</u>	<u>110'</u>	<u>130'</u>

WELL LOCATION:  
 sec 16 T 4 N R 5 E  
2 miles SE of Wetzel  
 (distance) (direction) (nearest town)

WELL PURPOSE: home  
 (home, irrigation, municipal, industrial)

- WELL COMPLETION DATA:
- (1) diameter (inches) 4"
  - (2) total depth (feet) 130
  - (3) static water level (feet) 80' below top of ground.
  - (4) casing PVC 120,  
 (material) (depth)  
4" if telescope see back.  
 (size)
  - (5) screen 10 120  
 (length) (depth to top)  
4" PVC  
 (size) (material)
  - (6) pump 1/2 10  
 (HP) (yield gpm)  
Elec  
 (type power)
  - (7) electric log No  
 (yes or no)
  - (8) how well bottom plugged Cap

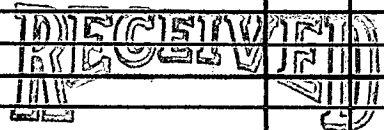


AUG 11 1986

Department of Natural Resources  
 Bureau of Land & Water Resources

DRILLERS REMARKS:

If well telescopes please sketch and show depths.

GROUND LEVEL

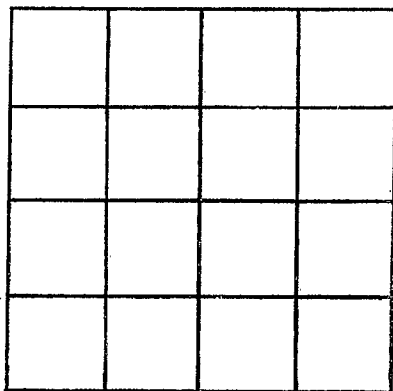

SECTION \_\_\_\_\_

Please indicate well location X.

ADDITIONAL INFORMATION

If more than one screen, show locations of each on sketch.